

WAYNE
C 45
12/73

MISSISSIPPI
 BOARD OF WATER COMMISSIONERS
 416 North State Street
 Jackson, Mississippi 39201

CODED

WATER WELL DRILLERS LOG

date well completed 19 McDONALD & Hill firm name Wayne county well located

LANDOWNER: Henry Carter
Rt 4 Wayneboro
Box 74
 (mailing address)

description of formations encountered	from	to
Clay	0	10
gumbo clay	10	35
Shale	35	48
Shale st. rock	48	55
Shale	55	134
Shale st. rock	134	154
fine sand	154	165
sandy shale st. rock	165	176
shale st. rock	176	200
shale st shells	200	210
Shale	210	232
st SAND shell & shale	232	244
st shale rock & SAND	244	256
BROWN shale	256	265
SAND st shale	265	310
SAND	310	330

WELL LOCATION:
 sec. 27T-14N R 7E
1 miles S of WIN AVE
 (distance) (direction) (nearest town)

WELL PURPOSE:
 (home, irrigation, municipal, industrial):

WELL COMPLETION DATA:

(1) diameter (inches) 4"

(2) total depth (feet) 330

(3) static water level (feet) 25 below above top of ground.

(4) casing PVC, 177'
 (material) (depth)

 if telescope see back.
 (size)

(5) screen 10'
 (length) (depth to top)

1 1/2" x 2" PVC
 (size) (material)

(6) pump (HP) (yield gpm)

 (type power)

(7) electric log (yes or no)

 (organization running log)

(8) how well bottom plugged


CODED

OCT 26 1973

DRILLERS REMARKS: See Book

If well telescopes please sketch and show depths.

GROUND LEVEL

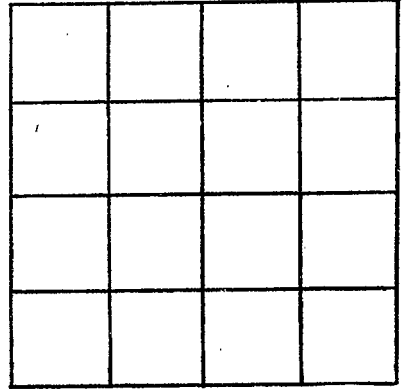

SECTION _____

Please indicate well location X.

ADDITIONAL INFORMATION

1 Broken h. wa. l.m.
1 rubber seal

If more than one screen,
show locations of each on sketch.