

WAYNE
C46
7-18-74

MISSISSIPPI
 BOARD OF WATER COMMISSIONERS
 416 North State Street
 Jackson, Mississippi 39201

CODED
 TECP

WATER WELL DRILLERS LOG

7.18.74 19 McDONALD & NICK WAYNE
 date well completed firm name county well located

LANDOWNER:	description of formations encountered	from	to
<u>Randy HODGES</u> <u>HIWAUKE MISS</u> (mailing address)			
WELL LOCATION:	<u>SHALE</u>	<u>20</u>	<u>140</u>
<u>sec 27 T10 N R 7 E</u> <u>1</u> miles <u>EAST</u> of <u>HIWAUKE</u> (distance) (direction) (nearest town)	<u>SAND & ST ROCKS</u>	<u>140</u>	<u>170</u>
WELL PURPOSE: <u>HOME</u> (home, irrigation, municipal, industrial)	<u>SHALE</u>	<u>170</u>	<u>290</u>
WELL COMPLETION DATA:	<u>SAND</u>	<u>290</u>	<u>310</u>
(1) diameter (inches) <u>4"</u>			
(2) total depth (feet) <u>310'</u>			
(3) static water level (feet) <u>140'</u> below top of ground.			
(4) casing <u>PVC</u> <u>190'</u> #40 (material) (depth) <u>4"</u> if telescope see back. (size)			
(5) screen <u>10'</u> <u>300'</u> (length) (depth to top) <u>2"</u> <u>PVC</u> (size) (material)			
(6) pump <u>1</u> <u>16</u> (HP) (yield gpm) <u>ELECTRIC</u> (type power)			
(7) electric log <u> </u> (yes or no) (organization running log)			
(8) how well bottom plugged <u>VALUE</u>			

CODED


DIAGNOSTIC
LOG
JUL 25 1974

MISS. BD. OF WATER COMMISSIONERS

DRILLERS REMARKS:
115' - 2" PVC
1 - 2x4 - R. SEAL

If well telescopes please sketch and show depths.

GROUND LEVEL

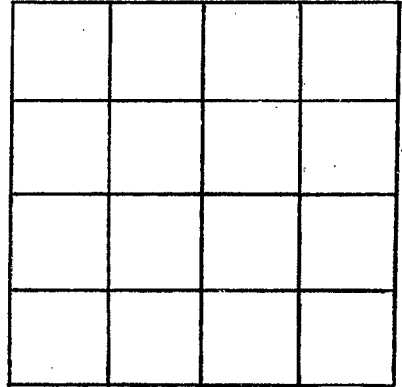

SECTION _____

Please indicate well location X.

ADDITIONAL INFORMATION

If more than one screen,
show locations of each on sketch.