

WAYNE  
C49  
9-31-75

MISSISSIPPI  
BOARD OF WATER COMMISSIONERS  
416 North State Street  
Jackson, Mississippi 39201

WATER WELL DRILLERS LOG

CODED

9-31-75 1975 Peoples Drilling Co Wayne  
date well completed firm name county well located

LANDOWNER: Jenny Daniels  
Rt 6 Box 235 N

description of formations encountered	from	to
Surface Clay to Pipe	0	21
Clay to 5' or 6'	21	42
Gumbo	42	83
lime	83	180
Sand	180	260

Waynesboro Miss  
(mailing address)

WELL LOCATION:  
sec. 10 T. 10 N. R. 7 E.  
S. W.  
2 miles S of Shubots  
(distance) (direction) (nearest town)

WELL PURPOSE: Home  
(home, irrigation, municipal, industrial)

WELL COMPLETION DATA:

(1) diameter (inches) 4"

(2) total depth (feet) 260

(3) static water level (feet) 60 below top of ground.

(4) casing 4" 180'  
(material) (depth)  
(size) if telescope see back.

(5) screen (length) (depth to top)  
(size) (material)

(6) pump 1/2 10  
(HP) (yield gpm)  
Flec.  
(type power)

(7) electric log NO  
(yes or no)  
(organization running log)

(8) how well bottom plugged Open

MISS. DR. OF WATER


DRILLERS REMARKS:

If well telescopes please sketch and show depths.

GROUND LEVEL

*Road Long -  
AWWSB*

*tion*

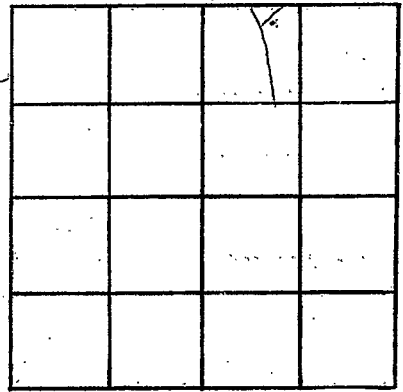

SECTION 10

Please indicate well location X.

ADDITIONAL INFORMATION

If more than one screen, show locations of each on sketch.