

WAYNE
C50
5/7/79

MISSISSIPPI
BOARD OF WATER COMMISSIONERS
416 North State Street
Jackson, Mississippi 39201

CODED

WATER WELL DRILLERS LOG

5-7 1979 Griner Drilling Wayne
date well completed firm name county well located

LANDOWNER:	description of formations encountered	from	to
Inexco Drilling 1100 Milam Bldg. Suite 1900 Houston, Texas (mailing address)			
WELL LOCATION: 1980' N + 1980' E of sec. 16 T-10 S R-7 E SW/4 cor 3 miles N of Hiwanee (distance) (direction) (nearest town)			
WELL PURPOSE: (home, irrigation, municipal, industrial)			
WELL COMPLETION DATA:			
(1) diameter (inches) 3"			
(2) total depth (feet) 315'			
(3) static water level (feet) _____ below top of ground. above			
(4) casing steel 189' (material) (depth) 3" if telescope see back. (size)			
(5) screen open ended (length) (depth to top) (size) (material)			
(6) pump _____ 15 (HP) (yield gpm) AC (type power)			
(7) electric log _____ (yes or no) (organization running log)			
(8) how well bottom plugged _____			
DRILLERS REMARKS:			


Miss. Board of Water Comm.

MAY 29 1979

RECEIVED

If well telescopes please sketch and show depths.

GROUND LEVEL

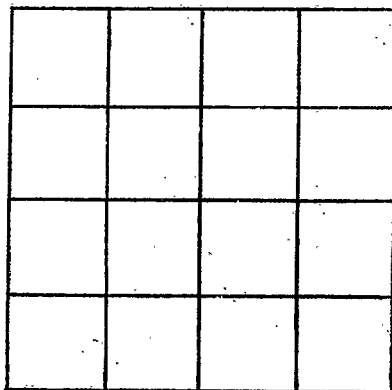

SECTION _____

Please indicate well location X.

ADDITIONAL INFORMATION

If more than one screen, show locations of each on sketch.