

WAYNE

C51

7/28/79

MISSISSIPPI BOARD OF WATER COMMISSIONERS 416 North State Street Jackson, Mississippi 39201

CODED

WATER WELL DRILLERS LOG

July 28 1979 Porter Drilling Thayne date well completed firm name county well located

LANDOWNER: Jack Stanley

Table with 3 columns: description of formations encountered, from, to. Rows include: rock - Vicksburg, clay, rock strata, clay, rock strata, coarse sand, rock, sand, rock strata, clay, muddy branch, clay, clay & sand, sand & clay, clay, clay & sand, sand, still in sand.

Thayne, Miss (mailing address)

WELL LOCATION: sec 26 T 10 N R 7 2 miles E of Fumel (distance) (direction) (nearest town)

WELL PURPOSE: home (home, irrigation, municipal, industrial)

- WELL COMPLETION DATA: (1) diameter (inches) 2 (2) total depth (feet) 355 (3) static water level (feet) 74 below top of ground (4) casing steel 340 (material) (depth) 2" (size) If telescope see back. (5) screen 15' 340 (length) (depth to top) 2" (size) ball SS (material) (6) pump 2 15 (HP) (yield gpm) elec (type power) (7) electric log no (yes or no) (organization running log) (8) how well bottom plugged 2" sand blank

105' 1/4' galv. drop pipe

Miss. Board of Water Comm.


SEP 10 1979

RECEIVED

DRILLERS REMARKS: steel trap 20' 4" PVC casing lost circulation at 10'

If well telescopes please sketch and show depths.

GROUND LEVEL

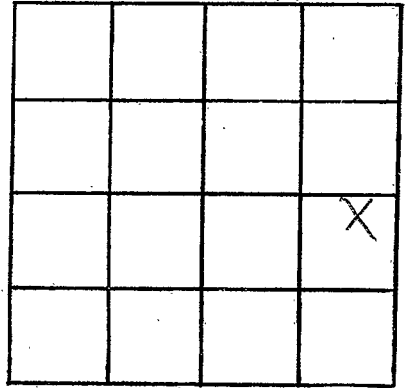

SECTION 26

Please indicate well location X.

ADDITIONAL INFORMATION

If more than one screen,
show locations of each on sketch.