

WAYNE

CLARKE

C 52

11-9-79

MISSISSIPPI BOARD OF WATER COMMISSIONERS  
416 North State Street  
Jackson, Mississippi 39201

CODED

WATER WELL DRILLERS LOG

WAYNE

11-9-79

Griner Drilling

Clarke

date well completed

firm name

county well located

LANDOWNER:

Ladd Petroleum  
2900 Veterans Blvd  
Metairie, La

(mailing address)

description of formations encountered

from

to

Top Soil 0 21  
Chalk + rock 21 336  
Chalk + sand 336 400

WELL LOCATION: 660' N 2660' E

Sec 13 T 10 N R 7 E of

Chaparral Field

(distance) (direction) (nearest town)

CODED

WELL PURPOSE: oil field supply  
(home, irrigation, municipal, industrial)

WELL COMPLETION DATA:

- (1) diameter (inches) 3"
- (2) total depth (feet) 400'
- (3) static water level (feet) 60' below top of ground.
- (4) casing steel, 336' (material) (depth)  
3" (size) If telescope see back.
- (5) screen 42', 294' (length) (depth to top)  
3" perforated (size) (material)
- (6) pump (HP) 60 (yield gpm)  
AE (type power)
- (7) electric log (yes or no)

(organization running log)

- (8) how well bottom plugged orange  
peel

DRILLERS REMARKS:


DEPT. OF NATURAL RESOURCES  
BUREAU OF LAND & WATER RESOURCES

DEC 19 1979

RECEIVED

If well telescopes please sketch and show depths.

GROUND LEVEL

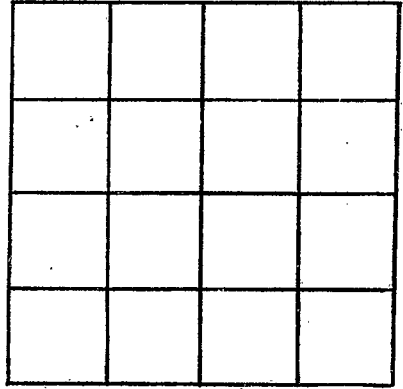

SECTION \_\_\_\_\_

Please indicate well location X.

ADDITIONAL INFORMATION

If more than one screen,  
show locations of each on sketch.