

WAYNE
C 53
3-4-80

MISSISSIPPI
BOARD OF WATER COMMISSIONERS
416 North State Street
Jackson, Mississippi 39201

CODED

WATER WELL DRILLERS LOG

3-4-80 Griner Drilling Wayne

date well completed

firm name

county well located

LANDOWNER:	description of formations encountered	from	to
Inexco 1100 Milam Bldg Suite 1900 Houston, (mailing address) TX	sand + pea gravel	0	25
WELL LOCATION: 2040'N + 2036'E No. 1 C.B. sec. 21 T. 100 R. 7 E. of Esuitor North Hivance Field	clay, rock, + sand	25	105
(distance) (direction) (nearest town)	clay, sand	105	210
WELL PURPOSE: oil field supply (home, irrigation, municipal, industrial)	sand	210	274
WELL COMPLETION DATA:	clay, sand	274	300
(1) diameter (inches) 3"			
(2) total depth (feet) 300'			
(3) static water level (feet) 10' ^{below} top of ground.			
(4) casing steel 273' (material) (depth)			
3" (size) if telescope see back.			
(5) screen 42' 231' (length) (depth to top)			
3" perforated (size) (material)			
(6) pump — 80 (HP) (yield gpm)			
AC (type power)			
(7) electric log — (yes or no)			
(organization running log)			
(8) how well bottom plugged orange peel			
DRILLERS REMARKS:			

CODED


DEPT. OF NATURAL RESOURCES
BUREAU OF LAND & WATER RESOURCES

MAR 17 1980

RECEIVED

If well telescopes please sketch and show depths.

GROUND LEVEL

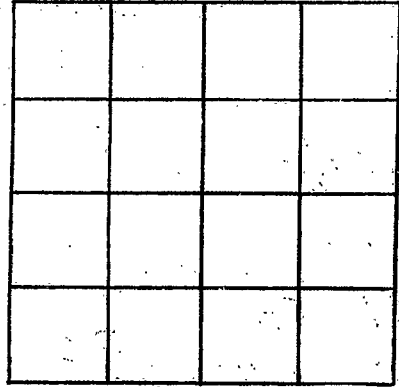

SECTION _____

Please indicate well location X.

ADDITIONAL INFORMATION

If more than one screen,
show locations of each on sketch.