

WAYNE
C 60

MISSISSIPPI
BOARD OF WATER COMMISSIONERS
416 North State Street
Jackson, Mississippi 39201

CODED

WATER WELL DRILLERS LOG

2/2 1987 CARB'S WELL SER. WAYNE
date well completed firm name county well located

LANDOWNER: ENERGY
DRILLING CO.
(611 FIELD WATCHER)
(mailing address)

| description of formations encountered | from | to |
|---------------------------------------|------|-----|
| 7:11 DIRT | 0 | 4 |
| TOP SOIL | 4 | 5 |
| CLAY | 5 | 8 |
| SAND | 8 | 26 |
| BLUE CHALK | 26 | 30 |
| THIN RB BLUE CLAY | 30 | 41 |
| 1" " CHALK | 41 | 124 |
| ROCK STRATER | 124 | 143 |
| SAND ROCKS | 143 | 158 |
| ROCK STRATER | 158 | 162 |
| BLUE CLAY | 162 | 258 |
| SPRING TO REA | 258 | 292 |

WELL LOCATION:
sec. 19 T. 10 N. R. 7 E. W.
4 miles W SW of THUBUTA
(distance) (direction) (nearest town)

WELL PURPOSE: OIL RIG
(home, irrigation, municipal, industrial)

- WELL COMPLETION DATA:
- (1) diameter (inches) 4"
 - (2) total depth (feet) 292
 - (3) static water level (feet) 18 (below top of ground)
 - (4) casing P.V.C., 252 (material) (depth)
4" (size) if telescope see back.
 - (5) screen 40', 252 (length) (depth to top)
4" P.V.C. (size) (material)
 - (6) pump AIR LIFT (HP) (yield gpm)
 - (type power)
 - (7) electric log NO (yes or no)
(organization running log)
 - (8) how well bottom plugged 2" (D.W. V.)

CODED

RECEIVED


FEB 20 1987

Department of Natural Resources
Bureau of Land & Water Resources

DRILLERS REMARKS:
STOPPED IN CHALK

If well telescopes please sketch and show depths.

GROUND LEVEL

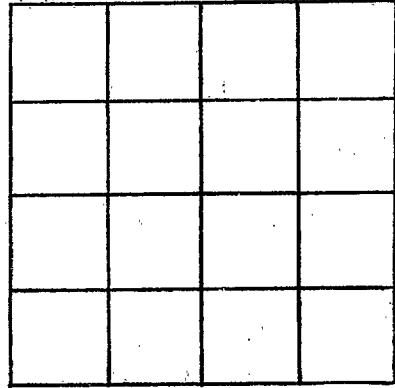

SECTION _____

Please indicate well location X.

ADDITIONAL INFORMATION

If more than one screen,
show locations of each on sketch.