

WAYNE
C 2000
1-16-76

MISSISSIPPI
 BOARD OF WATER COMMISSIONERS
 416 North State Street
 Jackson, Mississippi 39201

WATER WELL DRILLERS LOG

1-16-76 date well completed 1976 Williamson Drilling Co. firm name Wayne county well located

LANDOWNER: Jack Chapman
116 Bell H.W. 19
Waynesboro Miss.
 (mailing address)

description of formations encountered	from	to
<u>top soil</u>	<u>0</u>	<u>3</u>
<u>blue clay</u>	<u>3</u>	<u>65</u>
<u>mixed sand & clay</u>	<u>65</u>	<u>125</u>
<u>blue clay</u>	<u>125</u>	<u>157</u>
<u>sand</u>	<u>157</u>	<u>180</u>

WELL LOCATION:
 sec 27 T 10N R 7E
1/2 miles East of Waynesboro
 (distance) (direction) (nearest town)

WELL PURPOSE: Home
 (home, irrigation, municipal, industrial)

- WELL COMPLETION DATA:
- (1) diameter (inches) 2
 - (2) total depth (feet) 180
 - (3) static water level (feet) 55 ^(below) above of ground.
 - (4) casing PVC, 175,
 (material) (depth)
2 If telescope see back.
 (size)
 - (5) screen 5, 175
 (length) (depth to top)
12, PVC
 (size) (material)
 - (6) pump 1, 5
 (HP) (yield gpm)
Elect
 (type power)
 - (7) electric log No
 (yes or no)
hm
 (organization running log)


(8) how well bottom plugged Back
Wash Water

DRILLERS REMARKS:

DEC 1975
 MAY 24 1976
 MISS. RD. OF WATER COMMISSIONERS

If well telescopes please sketch and show depths.

GROUND LEVEL

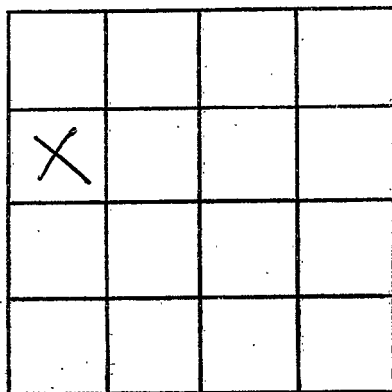

SECTION 27

Please indicate well location X.

ADDITIONAL INFORMATION

If more than one screen, show locations of each on sketch.