

Wayne
 C 2001
 1-16-76

MISSISSIPPI
 BOARD OF WATER COMMISSIONERS
 416 North State Street
 Jackson, Mississippi 39201

WATER WELL DRILLERS LOG

1-16-76 13P date well completed
 Williamson Drilling Co. firm name
 Wayne county well located

LANDOWNER: Danny Chapman
PO Box 94W 39
Waynesboro Miss
 (mailing address)


description of formations encountered	from	to
top soil	0	3
Blue Clay	3	63
striped sand & clay	63	118
Blue Clay	118	177
striped sand & clay	177	265
fine sand	265	284

WELL LOCATION:
 sec. 27 T. 10 N. R. 7 E. S. 4
4 miles S of Shubuta
 (distance) (direction) (nearest town)

WELL PURPOSE: Home
 (home, irrigation, municipal, industrial)

- WELL COMPLETION DATA:
- (1) diameter (inches) 4
 - (2) total depth (feet) 284
 - (3) static water level (feet) 55 below top of ground.
 - (4) casing PVC 127
 (material) (depth)
 - 4 If telescope see back.
 (size)
 - (5) screen 91 263
 (length) (depth to top)
 - 90 elbow
 (size) (material)
 - (6) pump 1 6
 (HP) (yield gpm)
 - Elect
 (type power)
 - (7) electric log no
 (yes or no)
 - no
 (organization running log)
 - (8) how well bottom plugged Back
Wash Valve

DRILLERS REMARKS:

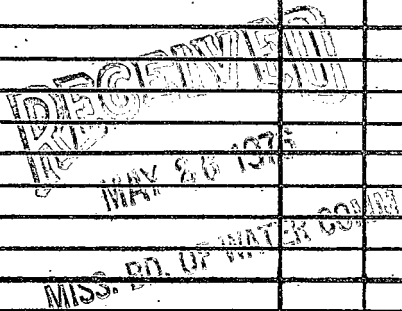

If well telescopes please sketch and show depths.

GROUND LEVEL

127'
4" pvc

Lead
seal →

147'
2" metal
pipe

21'
#90 brass
screen

Backwash valve

X			

SECTION 27

Please indicate well location X.

ADDITIONAL INFORMATION

If more than one screen,
show locations of each on sketch.