

Wayne
C 2002
1-19-76

MISSISSIPPI
 BOARD OF WATER COMMISSIONERS
 416 North State Street
 Jackson, Mississippi 39201

WATER WELL DRILLERS LOG

1-19-76 19 Wilkinson Drilling Co. Wayne
 date well completed: firm name county well located

LANDOWNER Bobby Pickens
P.O. Box # W. 59
Waynesboro Miss.
 (mailing address)

description of formations encountered	from	to
<u>red Clay</u>	<u>0</u>	<u>12</u>
<u>blue Clay</u>	<u>13</u>	<u>113</u>
<u>pink sand + Clay</u>	<u>113</u>	<u>195</u>
<u>sand</u>	<u>195</u>	<u>220</u>

WELL LOCATION:
 sec 27 T. 10 N. R. 7 E
4 miles S of Shubuta
 (distance) (direction) (nearest town)

WELL PURPOSE: Home
 (home, irrigation, municipal, industrial)


WELL COMPLETION DATA:
 (1) diameter (inches) 9
 (2) total depth (feet) 220
 (3) static water level (feet) 95 below top of ground.
 (4) casing PVC 210
 (material) (depth)
2" if telescope see back.
 (size)
 (5) screen 10 210
 (length) (depth to top)
12 PVC
 (size) (material)
 (6) pump 1 5
 (HP) (yield gpm)
Elect.
 (type power)
 (7) electric log no
 (yes or no)
no
 (organization running log)
 (8) how well bottom plugged Rock
Wash Valve

DRILLERS REMARKS:

RECORDED
 INDEXED
 MAY 25 1976
 MISS. DEPT. OF WATER CONTROL

If well telescopes please sketch and show depths.

GROUND LEVEL

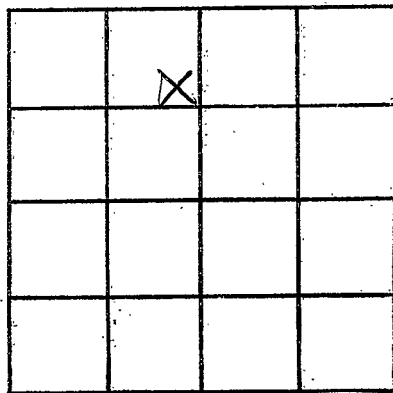

SECTION 27

Please indicate well location X.

ADDITIONAL INFORMATION

If more than one screen, show locations of each on sketch.