

Wayne
 C 2003
 5-10-76

MISSISSIPPI
 BOARD OF WATER COMMISSIONERS
 416 North State Street
 Jackson, Mississippi 39201

WATER WELL DRILLERS LOG

5.10.76 19 McDONALD + HILL WAYNE
 date well completed firm name county/well located

LANDOWNER:
LULA LUKES
 Rte 4 WAYNESBORO
 (mailing address)

WELL LOCATION:
 sec 36 T. 10 N. R. 7 E
4 miles SOUTH of Shubuta
 (distance) (direction) (nearest town)

WELL PURPOSE: 1/2 OMF
 (home) Irrigation, municipal, industrial)

WELL COMPLETION DATA:

(1) diameter (inches) 4"

(2) total depth (feet) 475'

(3) static water level (feet) 160' below top of ground.

(4) casing pvc, 290'
 (material) (depth)
4" if telescope see back.
 (size)


(5) screen 10, 465'
 (length) (depth to top)
2" pvc
 (size) (material)

(6) pump 3/4 sub, 6
 (HP) (yield gpm)
E
 (type power)

(7) electric log
 (yes or no)

(8) how well bottom plugged VALUE

description of formations encountered	from	to
<u>Clay sand</u>	<u>0</u>	<u>36</u>
<u>Shale</u>	<u>36</u>	<u>90</u>
<u>SANDS</u>	<u>90</u>	<u>94</u>
<u>Shale</u>	<u>94</u>	<u>238</u>
<u>Green shale</u>	<u>230</u>	<u>290</u>
<u>Rock shale</u>	<u>290</u>	<u>308</u>
<u>Shale</u>	<u>308</u>	<u>410</u>
<u>Brown shale</u>	<u>410</u>	<u>440</u>
<u>sand</u>	<u>440</u>	<u>475</u>

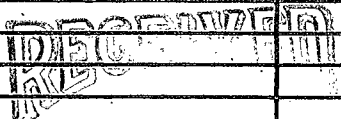


MAY 13 1976

DRILLERS REMARKS:
190' = 2" pvc
1 1/2 x 2 ROLLER SEA

If well telescopes please sketch and show depths.

GROUND LEVEL

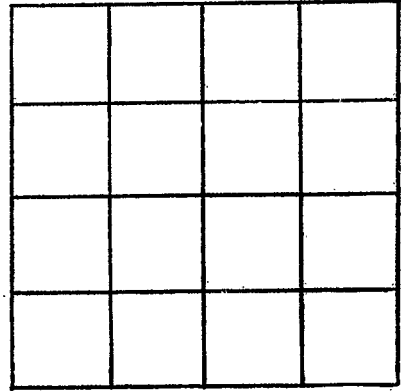

SECTION _____

Please indicate well location X.

ADDITIONAL INFORMATION

If more than one screen,
show locations of each on sketch.