

Wayne
C 2004
5-11-76

MISSISSIPPI
BOARD OF WATER COMMISSIONERS
416 North State Street
Jackson, Mississippi 39201

WATER WELL DRILLERS LOG

5.11.76 19 McDonald + Hill WAYNE
date well completed firm name county well located


LANDOWNER:	description of formations encountered	from	to
PERCY + MAMIE LOGAN	yellow clay	0	30
R#1 Shubuta Miss (mailing address)	Blue clay	30	90
WELL LOCATION: sec. 15 T 10 N R 10 E 2 miles South of Shubuta (distance) (direction) (nearest town)	Green clay	90	102
	Rock hole	102	110
WELL PURPOSE: HOME (home, irrigation, municipal, industrial)	soft shale	110	140
WELL COMPLETION DATA:	Blue clay	140	190
(1) diameter (inches) 4"	shale	190	218
(2) total depth (feet) 265	Brown shale standard	218	240
(3) static water level (feet) 72' below top of ground.	land	240	265
(4) casing PVC 140' (material) (depth) 4" (size) if telescope see back.			
(5) screen 10' 255' (length) (depth to top) 2" PVC (size) (material)			
(6) pump 1/2 sub 10 (HP) (yield gpm) E (type power)			
(7) electric log (yes or no)			
(organization running log)			
(8) how well bottom plugged VALUE			

RECEIVED
MAY 24 1976
MISS. BLD. OF WATER COMMISSIONERS

DRILLERS REMARKS:
115' - 2" PVC
1 - 4 X 2 SEAL

If well telescopes please sketch and show depths.

GROUND LEVEL

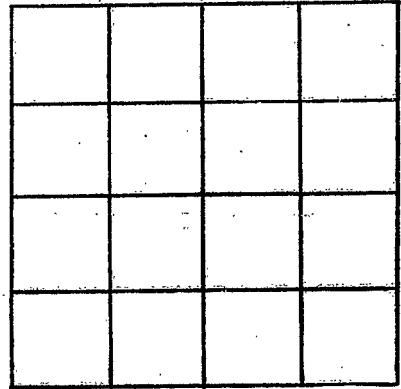

SECTION _____

Please indicate well location X.

ADDITIONAL INFORMATION

If more than one screen,
show locations of each on sketch.