

Wayne  
Cabus  
11/15/76

MISSISSIPPI  
BOARD OF WATER COMMISSIONERS  
416 North State Street  
Jackson, Mississippi 39201

13P

WATER WELL DRILLERS LOG

Nov 15 1976 date well completed  
26 Porter Drilling & Log firm name  
Wayne county well located


LANDOWNER: Eugene Bradley	description of formations encountered	from	to
P.O. 1 Shubuta Miss (mailing address)	red clay & sand brown sand clay	0	15 24 26
WELL LOCATION: sec 30 T 10 N R 7 E 9 miles NW of Shubuta Miss (distance) (direction) (nearest town)	17' 1" P.V.C. log		
WELL PURPOSE: none (home, irrigation, municipal, industrial)	Piggy		
WELL COMPLETION DATA: (1) diameter (inches) 2' (2) total depth (feet) 24' (3) static water level (feet) 14' below top of ground. (4) casing P.V.C. 20' (material) (depth) 2' (size) If telescope see back. (5) screen 4' 20' (length) (depth to top) 2' (size) 6 shot S.S. (material) (6) pump 1 (HP) 12 (yield gpm) clar (type power) (7) electric log yes (yes or no) (organization running log) (8) how well bottom plugged steel plug			
DRILLERS REMARKS:			

RECEIVED  
DEC 6 1976

MISS. BD. OF WATER COMMISSIONERS

If well telescopes please sketch and show depths.

GROUND LEVEL

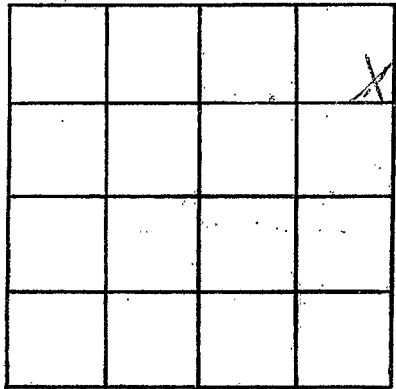

SECTION 30

Please indicate well location X.

ADDITIONAL INFORMATION

If more than one screen,  
show locations of each on sketch.