

Wayne
C 2000
5-13-80

MISSISSIPPI
BOARD OF WATER COMMISSIONERS
416 North State Street
Jackson, Mississippi 39201

WATER WELL DRILLERS LOG

March 21 1980 *Center Drillers & Log* *Wayne*
date well completed firm name county well located

LANDOWNER: *Jan Jaullner*
Box 1 Shubuta, Miss.
(mailing address)

description of formations encountered	from	to
<i>red clay</i>	<i>0</i>	<i>10</i>
<i>sand & gravel</i>	<i>10</i>	<i>67</i>
<i>clay & sand</i>	<i>69</i>	<i>80</i>
<i>blue clay</i>	<i>80</i>	<i>118</i>
<i>black sand rock</i>	<i>118</i>	<i>135</i>
<i>white clay & rock</i>	<i>135</i>	<i>150</i>

WELL LOCATION:
sec *31* T *10* N R *7* E
8 miles *NW* of *Waynesboro*
(distance) (direction) (nearest town)

description of formations encountered	from	to
<i>red clay</i>	<i>0</i>	<i>10</i>
<i>sand & gravel</i>	<i>10</i>	<i>67</i>
<i>clay & sand</i>	<i>69</i>	<i>80</i>
<i>blue clay</i>	<i>80</i>	<i>118</i>
<i>black sand rock</i>	<i>118</i>	<i>135</i>
<i>white clay & rock</i>	<i>135</i>	<i>150</i>

WELL PURPOSE: *Home*
(home, irrigation, municipal, industrial)

124' drop pipe

- WELL COMPLETION DATA:
- (1) diameter (inches) *2"*
 - (2) total depth (feet) *150'*
 - (3) static water level (feet) *27'* below above top of ground.
 - (4) casing *steel* *140'*
(material) (depth)
2'
(size) if telescope see back.
 - (5) screen *none used*
(length) (depth to top)
(size) (material)
 - (6) pump *2* *2*
(HP) (yield gpm)
elec
(type power)
 - (7) electric log *yes*
(yes or no)
(organization running log)
 - (8) how well bottom plugged *open*


description of formations encountered	from	to
<i>red clay</i>	<i>0</i>	<i>10</i>
<i>sand & gravel</i>	<i>10</i>	<i>67</i>
<i>clay & sand</i>	<i>69</i>	<i>80</i>
<i>blue clay</i>	<i>80</i>	<i>118</i>
<i>black sand rock</i>	<i>118</i>	<i>135</i>
<i>white clay & rock</i>	<i>135</i>	<i>150</i>
<i>3 1/2" bush set on redwood hole at 118' with 21" 2" lead pipe on 3 way bushing</i>		

DRILLERS REMARKS:

DEPT. OF NATURAL RESOURCES
BUREAU OF LAND & WATER RESOURCES
MAY 12 1980
RECEIVED

If well telescopes please sketch and show depths.

GROUND LEVEL

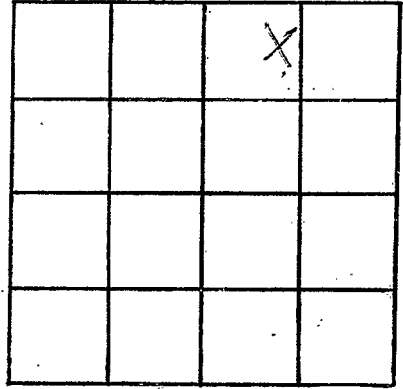

SECTION 31

Please indicate well location X.

ADDITIONAL INFORMATION

If more than one screen,
show locations of each on sketch.