

WAYNE

MISSISSIPPI  
BOARD OF WATER COMMISSIONERS  
416 North State Street  
Jackson, Mississippi 39201

WATER WELL DRILLERS LOG

C 2007  
6-18-80  
10-18-80

McDonalds Well  
firm name

Wayne  
county well located

LANDOWNER:

Grant Moore  
Rt #1 Shubuta  
(mailing address)

description of formations encountered

from to

sand clay & gravel	0	25
green shale	25	120
st sand & sandy shale + rock	120	145
shale	145	200
sandy shale + shells	200	225
fine sand & shale	225	245
sand	245	260

WELL LOCATION:

sec 19 T 10 N R 7 E  
5 miles S. E. of Shubuta  
(distance) (direction) (nearest town)

WELL PURPOSE:

home  
(home, irrigation, municipal, industrial)

WELL COMPLETION DATA:

- (1) diameter (inches) 4"
- (2) total depth (feet) 260'
- (3) static water level (feet) 5' below top of ground.
- (4) casing PVC 145'  
(material) (depth)  
4" if telescope see back.  
(size)
- (5) screen (length) (depth to top)  
(size) (material)
- (6) pump 1/2 400 gpm  
(HP) (yield gpm)  
E  
(type power)
- (7) electric log (yes or no)  
(organization running log)
- (8) how well bottom plugged open

DRILLERS REMARKS:


DEPT. OF NATURAL RESOURCES  
BUREAU OF LAND & WATER RESOURCES

JUN 25 1980

RECEIVED

If well telescopes please sketch and show depths.

GROUND LEVEL

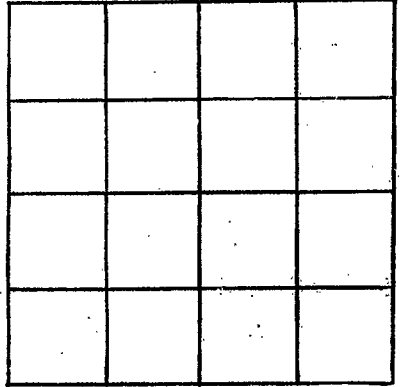

SECTION \_\_\_\_\_

Please indicate well location X.

ADDITIONAL INFORMATION

If more than one screen, show locations of each on sketch.