

WAYNE

MISSISSIPPI  
BOARD OF WATER COMMISSIONERS  
416 North State Street  
Jackson, Mississippi 39201

C. 2008

WATER WELL DRILLERS LOG

6-18-80

6-18-80

McDonald & Hill

Waynes

date well completed

firm name

county well located


| LANDOWNER:  | description of formations encountered | from | to  |
|---|---------------------------------------|------|-----|
| John Charles Carter   | clay                                  | 0    | 15  |
| Rt # 1 Box 293, Shelbourn<br>(mailing address)                      | sand                                  | 15   | 25  |
| WELL LOCATION:  | green shale                           | 25   | 125 |
| sec. 19 T. 10 N. R. 7 E   | sand & sandy shale & rock             | 125  | 145 |
| 5 miles S, E. of Shelbourn<br>(distance) (direction) (nearest town) | shale                                 | 145  | 210 |
| WELL PURPOSE: home<br>(home, irrigation, municipal, industrial)     | sandy shale & shells                  | 210  | 230 |
| WELL COMPLETION DATA:   | shale & sand                          | 230  | 250 |
| (1) diameter (inches) 9"  | sand                                  | 250  | 260 |
| (2) total depth (feet) 260'   |                                       |      |     |
| (3) static water level (feet) 5' below top of ground.               |                                       |      |     |
| (4) casing PVC 255'<br>(material) (depth)                           |                                       |      |     |
| 9" if telescope see back.<br>(size)                                 |                                       |      |     |
| (5) screen 5' 255' to 260'<br>(length) (depth to top)               |                                       |      |     |
| 9" PVC<br>(size) (material)   |                                       |      |     |
| (6) pump 1/2 490m<br>(HP) (yield gpm)                               |                                       |      |     |
| (type power)  |                                       |      |     |
| (7) electric log (yes or no)  |                                       |      |     |
| (organization running log)  |                                       |      |     |
| (8) how well bottom plugged value                                   |                                       |      |     |
| DRILLERS REMARKS:   |                                       |      |     |

DEPT. OF NATURAL RESOURCES  
BUREAU OF LAND & WATER RESOURCES

JUN 25 1980  
RECEIVED

If well telescopes please sketch and show depths.

GROUND LEVEL

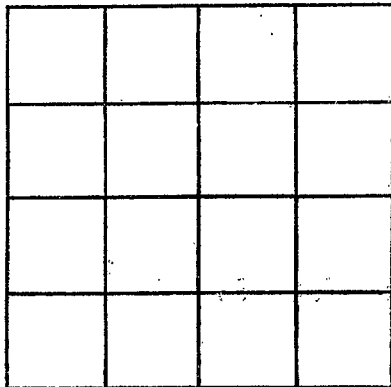

SECTION \_\_\_\_\_

Please indicate well location X.

ADDITIONAL INFORMATION

If more than one screen, show locations of each on sketch.