

MISSISSIPPI DEPARTMENT OF NATURAL RESOURCES

Bureau of Land and Water Resources

Southport Mall

P.O. Box 10631

Jackson, Mississippi 39209

WATER WELL DRILLERS LOG

**WAYNE**  
**C 2007**  
**8-19-80**

Aug 19 1980 Porter-Drilling & Pipe 21 Wayne  
 date well completed firm name county well located

LANDOWNER: Bill Stanley  
Box 1  
Hubata Miss.  
 (mailing address)

WELL LOCATION:  
 sec 31 T 10 (N) R 7 (E) S W  
8 miles N.W. of Waynesboro  
 (distance) (direction) (nearest town)

WELL PURPOSE: Home  
 (home, irrigation, municipal, industrial)

WELL COMPLETION DATA:

- (1) diameter (inches) 2"
- (2) total depth (feet) 317'
- (3) static water level (feet) 20' below top of ground.
- (4) casing P.V.C. 302'  
 (material) (depth)  
2' if telescope see back.  
 (size)
- (5) screen 15' 302'  
 (length) (depth to top)  
2' basot S.S.  
 (size) (material)
- (6) pump 1 15  
 (HP) (yield gpm)  
elec  
 (type power)
- (7) electric log no  
 (yes or no)
- (organization running log)
- (8) how well bottom plugged 2" sand shark

description of formations encountered	from	to
clay & sand	0	33
clean sand	33	45
sand & clay	45	51
clay	51	54
thin bed		54
clay	54	78
shalt rock		78
clay	78	88
shalt rock		88
clay	88	165
rock strata	165	185
sand & clay	185	192
rock strata	192	207
clay	207	259
shalt rock		259
clay lignite sand	259	282
thin bed sand	282	340
fine sand some lig.	340	345
slotted white shell in sand & lignite		
62' 1" P.V.C. drop pipe		


DEPT. OF NATURAL RESOURCES  
 BUREAU OF LAND & WATER RESOURCES

SEP 24 1980  
**RECEIVED**

DRILLERS REMARKS:

If well telescopes please  
sketch and show depths.

GROUND LEVEL

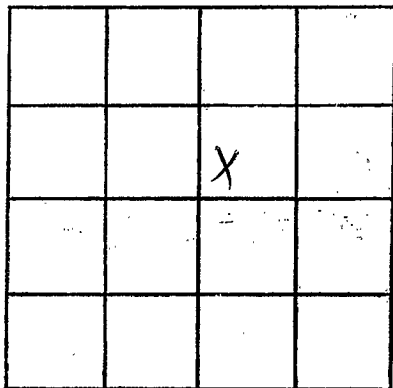

SECTION 31

Please indicate well location X.

ADDITIONAL INFORMATION

If more than one screen,  
show locations of each on sketch.