

D 15
7-15-64

WATER WELL DRILLERS LOG


Date July 15, 1964, Driller Porter Drilling Co. County Wayne
3 PT (Name)

(1) Owner of Land: Jim Gray
(Name)
Out 2 Waynesboro, Miss
(Address)
(2) Location: NW 1/4, NW 1/4, Sec. 31 T0 R6
4 miles east of Thwanes
(distance) (direction) (Nearest Town)
(3) Topography: hilly
(Hilly) (Flat) (Level)
(4) Purpose of Well: domestic
(Domestic Irrigation, Municipal, Industrial, Other)

Description & Color of Materials Sand, Clay, Red Clay, Shell, etc.	Thick- ness Feet	Depth Feet
red clay	8	8
sand & white chalk	23	31
chalk	5	36
sand	4	40
rock	1	41
blue chalk	56	97
streaks of coarse red		
sand	4	101
white chalk	6	107
shell & white chalk	3	110
gritty white chalk	23	133
rock	1	134
chalk	5	139
soft rock	3	142
soft blue chalk	88	230
thin rock		230
soft blue chalk	15	245
streaks of soft rock	5	250
soft blue chalk	65	315
rough rock strata	21	336
with sand pockets		
blue chalk	11	347
rock strata	5	352
chalk green hard	62	414
soft rock	4	418
sand lignite & shale	27	445
chalk	25	470
sand with chalk		
stayed on chalk		20 490

Information upon completion of well:

(1) Diameter 2" inches.
(2) Total Depth 490' feet.
(3) Water Level 204' feet below top of ground.
(4) Cased to 445', Size 2"
(5) Screen: Size 1/4", Length 18'
(6) Were any formations sealed against pollution?
_____ yes, X no.
If YES depth of formation _____
Why _____
Drillers Remarks: _____

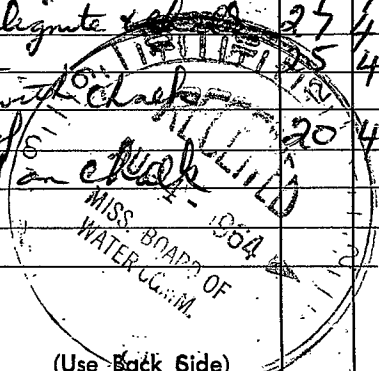

(Use Back Side)

Well No.

