

Wayne
D17
8-11-66

MISSISSIPPI BOARD OF WATER COMMISSIONERS

WATER WELL DRILLERS LOG

Date: Aug 11, 1966, Driller: Boiter Drilling Shop County Wayne
3 P (Name)

(1) Owner of Land: Henry M. O'Don
(Name)
P.O. Box 587 Waynesboro, Miss
(Address)
(2) Location: SE 1/4, SE 1/4, Sec. 18 T10 R2E
1.5 miles NE of Waynesboro
(distance) (direction) (Nearest Town)
(3) Topography: Hilly
(Hilly) (Flat) (Level)
(4) Purpose of Well: domestic
(Domestic Irrigation
Municipal, Industrial, Other)


Description & Color of Materials Sand, Clay, Red Clay, Shell, etc.	Thick- ness Feet	Depth Feet
red chalk	6	6
red sand	8	14
sand & chalk	11	25
rock	1	26
sand & chalk	3	29
blue chalk	22	51
rock	2	53
blue chalk	57	110
rock	2	112
shale	4	116
lignite, chalk & fine sand	44	160
sand & chalk	12	172
chalk, sand & lignite	21	193
blue chalk	49	242
chalk, shale & some sand	14	256
rock strata	16	272
sand	6	278
chalk	2	280
rock strata & tight sand	14	294
blue chalk	5	299
rock	2	301
blue chalk	95	396
Clean med coarse sand	16	412

Information upon completion of well:

(1) Diameter 2" inches.
(2) Total Depth 412' feet.
(3) Water Level 51' feet below top of ground.
(4) Cased to 401', Size 2"
(5) Screen: Size 1 1/4", Length 10'
80 ga
(6) Were any formations sealed against pollution?
no

in sand
water
a little

If YES depth of formation _____
Why _____
Drillers Remarks: _____

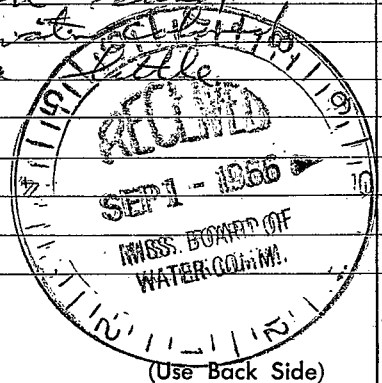

(Use Back Side)

Well No.

