

WAYNE

~~CLARK~~

D18 ~~25~~

2-5-71

MISSISSIPPI
BOARD OF WATER COMMISSIONERS
416 North State Street
Jackson, Mississippi 39201

CODED

WATER WELL DRILLERS LOG

Feb 5 1971 Porter Drilling & Log Clark
date well completed firm name county well located

LANDOWNER: Wayne Jones
1101 Spring St
Waynesboro Miss
11 (mailing address)

WELL LOCATION:
sec 2 T 100 N R 6 E
1 miles N of Waynesboro
(distance) (direction) (nearest town)

WELL PURPOSE: Home
(home, irrigation, municipal, industrial)

WELL COMPLETION DATA:
(1) diameter (inches) 4"
(2) total depth (feet) 164
(3) static water level (feet) 73 below above top of ground.
(4) casing steel 125'
(material) (depth)
4' if telescope see back.
(size)
(5) screen 20' 132'
(length) (depth to top)
3200 5.5 200
(size) (material)
(6) pump 1 7
(HP) (yield gpm)
elec.
(type power)
(7) electric log no
(yes or no)
(organization running log)
(8) how well bottom plugged not plugged

| description of formations encountered | from | to |
|---------------------------------------|------|-----|
| red clay | 0 | 21 |
| rock | 21 | 22 |
| blue chalk | 22 | 32 |
| thin rock | 32 | |
| blue chalk | 32 | 76 |
| rock strata & c | | |
| little sand | 96 | 105 |
| blue chalk | 105 | 116 |
| thin rock | | 116 |
| Chalk & sand | 116 | 135 |
| light sand | 135 | 147 |
| dark sand some | | |
| Chalk | 147 | 151 |
| sand & chalk | 151 | 156 |
| light sand | 156 | 162 |
| Chalk | 162 | 164 |

CODED


20' 3200 5.5 screen
with 12' 2" tail pipe
below screen & 1/4"
8' 2 1/2" cap going c
above & start in
with rubber packer
84' 2 1/2" x 21' 2"
tubing 82' 1 1/4"
change pipe

DRILLERS REMARKS:

MAR 12 1971

If well telescopes please sketch and show depths.

GROUND LEVEL

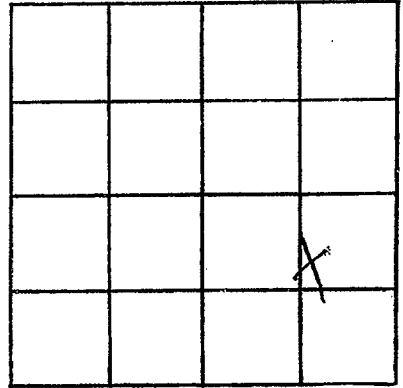

SECTION 2

Please indicate well location X.

ADDITIONAL INFORMATION

If more than one screen,
show locations of each on sketch.