

**MISSISSIPPI  
BOARD OF WATER COMMISSIONERS**  
416 North State Street  
Jackson, Mississippi 39201

**CODED**

**WATER WELL DRILLERS LOG**

Wayne
D 19
2-10-68

2-10 date well completed      1968 firm name Grinn Drilling Service      Wayne county well located

LANDOWNER: <u>H. A. Clephan</u>	description of formations encountered	from	to
	<u>Blue clay + rock</u>	<u>0</u>	<u>230</u>
	<u>fine sand</u>	<u>230</u>	<u>242</u>
	<u>blue clay</u>	<u>242</u>	<u>257</u>
(mailing address)	<u>medium blue sand</u>	<u>257</u>	<u>296</u>

**WELL LOCATION:**  
400 ft from N + W lines Sec 19-10N-4W  
sec 19 T 10 S R 6 E  
4 miles SE of Shubuta  
(distance) (direction) (nearest town)

**WELL PURPOSE:**  
(home, irrigation, municipal, industrial)

**WELL COMPLETION DATA:**

(1) diameter (inches) 3

(2) total depth (feet) 296

(3) static water level (feet) \_\_\_\_\_ below above top of ground.

(4) casing steel (material), 296 (depth),  
\_\_\_\_\_ if telescope see back.  
(size)

(5) screen 20 (length), \_\_\_\_\_ (depth to top)  
3" (size), slotted pipe (material)

(6) pump \_\_\_\_\_ (HP), 65 (yield gpm)  
air lift (type power)

(7) electric log NO (yes or no)  
\_\_\_\_\_  
(organization running log)

(8) how well bottom plugged welded


**DRILLERS REMARKS:**

FEB 18 1968

MISS. BD. OF WATER COMMISSIONERS

If well telescopes please sketch and show depths.

GROUND LEVEL

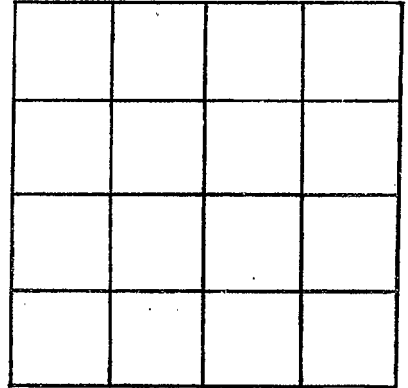

SECTION 79

Please indicate well location X.

ADDITIONAL INFORMATION

If more than one screen,  
show locations of each on sketch.