

Wayne
D 20
4-8-70

MISSISSIPPI
BOARD OF WATER COMMISSIONERS
416 North State Street
Jackson, Mississippi 39201

WATER WELL DRILLERS LOG

April 8 1970 Porter Drilling & Log Wayne
date well completed firm name county well located


LANDOWNER: <u>J. J. Chapman</u>	description of formations encountered	from	to
<u>At 4 Wagnersboro Miss</u> (mailing address)	<u>chalk & clay</u>	<u>0</u>	<u>35</u>
WELL LOCATION:	<u>blue chalk</u>	<u>35</u>	<u>55</u>
sec. <u>19</u> T. <u>10</u> N. R. <u>6</u> E. <u>033</u>	<u>rock strata</u>	<u>55</u>	<u>70</u>
<u>10</u> miles <u>N</u> of <u>Wagnersboro</u>	<u>blue chalk</u>	<u>70</u>	<u>128</u>
(distance) (direction) (nearest town)	<u>rock strata</u>	<u>128</u>	<u>182</u>
WELL PURPOSE: <u>None</u>	<u>blue chalk</u>	<u>182</u>	<u>230</u>
(home, irrigation, municipal, industrial)	<u>Chalk weaned</u>	<u>230</u>	<u>250</u>
WELL COMPLETION DATA:	<u>fine sand</u>	<u>250</u>	<u>265</u>
(1) diameter (inches) <u>2"</u>	<u>blue chalk</u>	<u>265</u>	<u>278</u>
(2) total depth (feet) <u>311</u>	<u>sand & chalk</u>	<u>278</u>	<u>311</u>
(3) static water level (feet) <u>90</u> (below/above top of ground)	<u>stopped on chalk</u>		
(4) casing <u>steel</u> <u>2 84 1/2</u> (material) (depth)	<u>24' 1 1/4 80 ga S.S. with</u>		
<u>2"</u> (size) if telescope see back.	<u>5' 1 1/2 log tied in well</u>		
(5) screen <u>24'</u> <u>287'</u> (length) (depth to top)	<u>packer 147' 1 1/2 chrg pipe</u>		
<u>1 1/2</u> (size) <u>80 ga S.S.</u> (material)			
(6) pump <u>1 1/2</u> (HP) <u>4</u> (yield gpm)			
<u>elec</u> (type power)			
(7) electric log <u>no</u> (yes or no)			
(organization running log)			
(8) how well bottom plugged <u>flush ground</u>			
DRILLERS REMARKS:			

MAY 8 1970

MISS. BD. OF WATER COMMISSIONERS

If well telescopes please sketch and show depths.

GROUND LEVEL

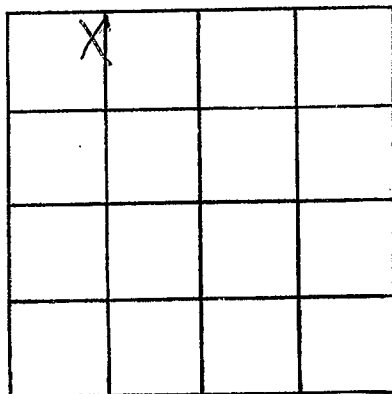

SECTION 19

Please indicate well location X.

ADDITIONAL INFORMATION

If more than one screen,
show locations of each on sketch.