

MISSISSIPPI
BOARD OF WATER COMMISSIONERS
416 North State Street
Jackson, Mississippi 39201

CODED

WATER WELL DRILLERS LOG

WAYNE
DZ
9-22-71

4-22-71 date well completed 1971 McDonald & Hill Inc firm name Wayne county well located

LANDOWNER: William R. Richards

description of formations encountered

from to

Rt # 2
Waynesboro, Miss
(mailing address)

Clay + sand	0	30
shale	30	90
sandy st Rock	90	105
shale	105	120
st fine sand	120	140
st green sand	140	160
sandy	160	180
shale	180	200

WELL LOCATION:

sec 2 T 10 N R 6 E
S W
2 miles east of Mathesville
(distance) (direction) (nearest town)

WELL PURPOSE: home
(home, irrigation, municipal, industrial)

WELL COMPLETION DATA:

- (1) diameter (inches) 4
- (2) total depth (feet) 200
- (3) static water level (feet) 97 below top of ground
- (4) casing 4" black 105 (material) (depth)
- no (size) if telescope see back.
- (5) screen no (length) (depth to top)
- (size) (material)
- (6) pump 1/2 10 (HP) (yield gpm)
- submersible (type power)
- (7) electric log no (yes or no)
- (organization running log)

CODED

APR 29 1971


(8) how well bottom plugged open

DRILLERS REMARKS: None

MISS. Bd. of WATER COMMISSIONERS

If well telescopes please sketch and show depths.

GROUND LEVEL

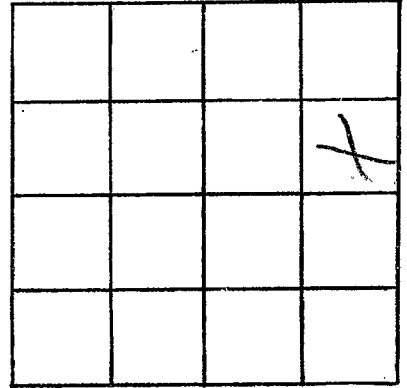

SECTION 2

Please indicate well location X.

ADDITIONAL INFORMATION

If more than one screen,
show locations of each on sketch.