

WAYNE  
D22  
4-14-71

MISSISSIPPI  
BOARD OF WATER COMMISSIONERS  
416 North State Street  
Jackson, Mississippi 39201

**CODED**

WATER WELL DRILLERS LOG

April 14 1971 North Drilling Corp Wayne  
(date well completed) (firm name) (county well located)

LANDOWNER: Wayne Taylor  
Highway 45 South  
Waynesboro Miss.  
(mailing address)

WELL LOCATION:  
sec 31 T. 10 N R. 6 E  
7 miles N of Waynesboro  
(distance) (direction) (nearest town)

WELL PURPOSE: camp & farm  
(home, irrigation, municipal, industrial)

- WELL COMPLETION DATA:
- (1) diameter (inches) 2"
  - (2) total depth (feet) 475'
  - (3) static water level (feet) 181' (below/above top of ground)
  - (4) casing steel 445 1/2'  
(material) (depth)  
2" (size) if telescope see back.
  - (5) screen 18' 457'  
(length) (depth to top)  
1 1/4" 80 ga S.S.  
(size) (material)
  - (6) pump 3/4 HP 3 1/2  
(HP) (yield gpm)  
elec  
(type power)
  - (7) electric log no  
(yes or no)  
  
(organization running log)

description of formations encountered	from	to
red clay	0	8
rounded sand	8	33
red chalk	33	40
blue chalk	40	48
rocks	48	50
blue chalk	50	68
Waynesboro dr	68	85
white chalk block	85	115
blue chalk	115	225
rough rock strata	225	235
blue chalk	235	292
rock strata	292	311
sand & chalk	311	322
rocks	322	324
sand - firm	324	329
rock strata	329	340
blue chalk	340	394
rock strata	394	400
chalk to sand	400	435
blue chalk	435	442
1/2" sand	442	475
stained white		
still in cement but with		
more steel		
18' 1 1/2" 80 ga S.S. with		
13' 1 1/2" cas. then on		
with packer		
and set at 47' with		
packer below to		
help support		


**CODED**  
MAY 6 - 1971

(8) how well bottom plugged  
flush point  
DRILLERS REMARKS:

MISS. DP. 015  
WATER COMM.

If well telescopes please sketch and show depths.

GROUND LEVEL

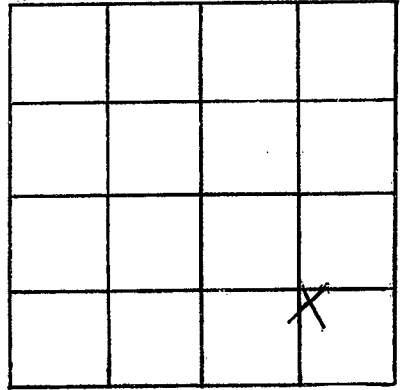

SECTION 31

Please indicate well location X.

ADDITIONAL INFORMATION

If more than one screen, show locations of each on sketch.