

WAYNE
D23
5-7-74

C. P. CLARK
MISSISSIPPI WATER WELL DRILLING
BOARD OF WATER COMMISSIONERS ROUTE 2
416 North State Street LAUREL, MISS. 39440
Jackson, Mississippi 39201

WATER WELL DRILLERS LOG CODED

5/7 1974 C.P. Clark Wayne
date well completed firm name county well located

LANDOWNER: Alex Mathews
Matherville, Miss

description of formations encountered	depth	
	from	to
Sandy Clay	0	7
Yellow Clay	7	16
Sand	16	22
Clay	22	30
Rock streaks	30	33
Clay	33	47
Rock	47	49
Clay	49	57
Rock	57	60
Clay	60	109
Rock	109	112
Clay & shells	112	116
Brown Clay	116	135
Brown Clay sand streaks	135	148
Sand	148	182
Clay	182	186

(mailing address)
WELL LOCATION:
sec. 2 T. 10N R. 6E
1/2 miles E of Matherville
(distance) (direction) (nearest town)

WELL PURPOSE: Home
(home, irrigation, municipal, industrial)

WELL COMPLETION DATA:


- (1) diameter (inches) 2
- (2) total depth (feet) 182
- (3) static water level (feet) 52 below top of ground.
- (4) casing Galv. Iron 177 (material) (depth)
- (5) screen 5 177 (length) (depth to top)
- 1 1/4 518.006 (size) (material)
- (6) pump 1 1/2 15 (HP) (yield gpm)
- 220V (type power)
- (7) electric log NO (yes or no)
- (organization running log)
- (8) how well bottom plugged Bus. V.

DRILLERS REMARKS: Set 13A
at @ 84 Sta. 10E
Pump # 120 Gal tank
House has 5 baths

PROCESSED
MAY 13 1974
WATER COMMISSION

If well telescopes please sketch and show depths.

GROUND LEVEL

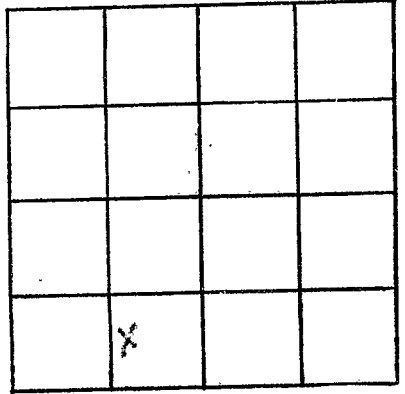

SECTION 2

Please indicate well location X.

ADDITIONAL INFORMATION

If more than one screen, show locations of each on sketch.