

WAYNE

D 26

9/24/74

MISSISSIPPI BOARD OF WATER COMMISSIONERS 416 North State Street Jackson, Mississippi 39201

WATER WELL DRILLERS LOG

Sept 24 1974 R. Smith & Sons, Inc. Wayne

date well completed

firm name

county well located

LANDOWNER: Johnny Cook, Jr. Greenville, Miss

description of formations encountered from to

Greenville, Miss (mailing address)

Table with 3 columns: description of formations encountered, from, to. Rows include: sand clay & chalk (0-14), wet sand (14-28), Chalk (28-36), sand & strata (36-41), Chalk (41-45), Chalk & a little sand (45-57), sand & chalk (57-65), thin clean fine sand (65-182)

WELL LOCATION:

sec. 1 T 10 N R 6 E S 2 miles E of Greenville

WELL PURPOSE: none (home, irrigation, municipal, industrial)

WELL COMPLETION DATA:


- (1) diameter (inches) 2"
(2) total depth (feet) 182
(3) static water level (feet) 101 (below top of ground)
(4) casing PVC 173' (material) (depth) 2" (size) if telescope see back.
(5) screen 9' 173' (length) (depth to top) 1 1/2" 55 (size) (material)
(6) pump 1/2 5 gal (HP) (yield gpm) elec. (type power)
(7) electric log no (yes or no)

stagnant white stuff in filter casing
WELL
9' 1 1/2" 6 shot 55
screen on casing with back wash valve on end and steel trap above
1 1/2" 1" P.V.C. drop pipe

(organization running log)

(8) how well bottom plugged back wash valve


DRILLERS REMARKS:

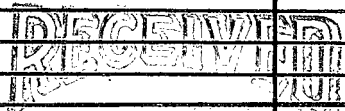

OCT 26 1974

If well telescopes please sketch and show depths.

GROUND LEVEL

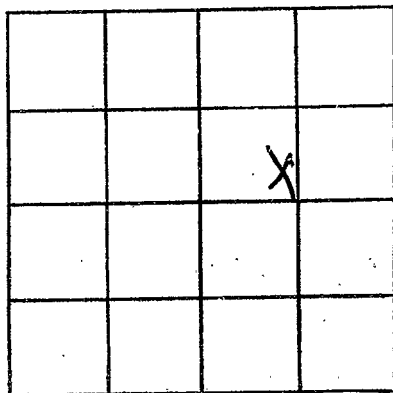

SECTION 1

Please indicate well location X.

ADDITIONAL INFORMATION

If more than one screen, show locations of each on sketch.