

WAYNE
D 27
5/24/79

MISSISSIPPI
BOARD OF WATER COMMISSIONERS CODED
416 North State Street
Jackson, Mississippi 39201

WATER WELL DRILLERS LOG

5-24-79 Griner Drilling Wayne
date well completed firm name county well located

LANDOWNER:
Larco Drilling
1700 Capital Towers
Jackson, MS 39205
(mailing address)

description of formations encountered	from	to
chalk	0	378
sand	378	400

WELL LOCATION: 200' S + 500' W
sec. 9 T. 10 N R. 6 E of
Mathersville
(distance) (direction) (nearest town)

WELL PURPOSE: oil field supply
(home, irrigation, municipal, industrial)

- WELL COMPLETION DATA:
- (1) diameter (inches) 3"
 - (2) total depth (feet) 400'
 - (3) static water level (feet) 200' Below top of ground.
 - (4) casing steel 378' (material) (depth)
3" (size) If telescope see back.
 - (5) screen open ended (length) (depth to top)
 - (6) pump 55 (HP) (yield gpm)
AC (type power)
 - (7) electric log (yes or no)
 - (8) how well bottom plugged

DRILLERS REMARKS:


Miss. Board of Water Comm.

MAY 29 1979

RECEIVED

If well telescopes please sketch and show depths.

GROUND LEVEL

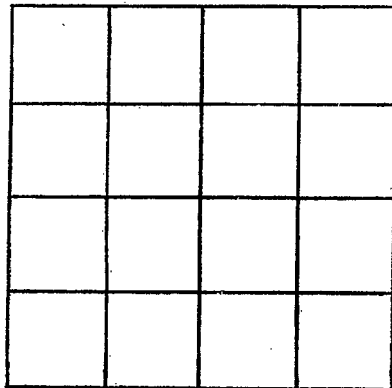

SECTION _____

Please indicate well location X.

ADDITIONAL INFORMATION

If more than one screen, show locations of each on sketch.