

MISSISSIPPI DEPARTMENT OF NATURAL RESOURCES

Bureau of Land and Water Resources

Southport Mall

P.O. Box 10631

Jackson, Mississippi 39209

CODED

WATER WELL DRILLERS LOG

Wayne
D 29
11-7-81

11-7-81

Griner Drilling Service, Inc.

Wayne

date well completed

firm name

county well located

LANDOWNER:

Vantage Oil Company

Jackson, MS

(mailing address)

description of formations encountered

from

to

chalk

0 21

chalk, rock

21 168

sand, shell

168 210

sand, chalk

210 231

chalk

231 294

streaked

294 504

WELL LOCATION: 1890' N. 575' E

sec. 26 T. 10 S. R. 6 E Sulfur

No. 1 Cypress Creek Field
Griner Drilling Service, Inc. (distance) (direction) (nearest town)

WELL PURPOSE: oil field supply
(home, irrigation, municipal, industrial)

WELL COMPLETION DATA:

(1) diameter (inches) 3"

(2) total depth (feet) 504'

(3) static water level (feet) 18' below top of ground.

(4) casing steel, 294' (material) (depth)

3" (size) if telescope see back.

(5) screen 42', 252' (length) (depth to top)

3" perforated (size) (material)

(6) pump — 75 (HP) (yield gpm)

AC (type power)

(7) electric log — (yes or no)

(organization running log)

(8) how well bottom plugged orange

peel

DRILLERS REMARKS:


CODED

DEPT. OF NATURAL RESOURCES
BUREAU OF LAND & WATER RESOURCES

RECEIVED
DEC 9 1981

If well telescopes please sketch and show depths.

GROUND LEVEL

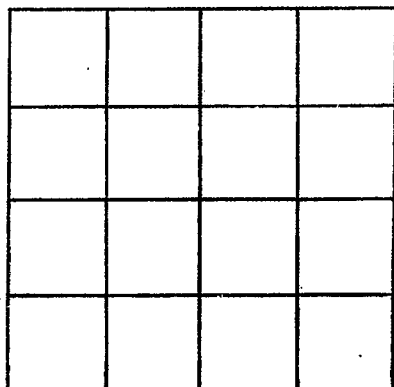

SECTION _____

Please indicate well location X.

ADDITIONAL INFORMATION

If more than one screen,
show locations of each on sketch.