

MISSISSIPPI DEPARTMENT OF NATURAL RESOURCES

Bureau of Land and Water Resources

Southport Mall

P.O. Box 10631

Jackson, Mississippi 39209

WATER WELL DRILLERS LOG

CODED

Wayne
D-30
2-26-82

Griner Drilling Service, Inc.

Wayne

date well completed

firm name

county well located

LANDOWNER:

Pruet Production
1515 Capital Towers
Jackson, Ms. 39205

(mailing address)

description of formations encountered

from

to

chalk, 5' of sand 0 21

chalk 21 105

WELL LOCATION: 2140' S + 900' W

sec. 12 T. 10 R. 6 NE/4

chalk, st. sand, shell 105 126

No. 1 Matherville
Hays (distance) miles (direction) of (nearest town)

streaked 126 210

12-8 WELL PURPOSE: oil field supply (home, irrigation, municipal, industrial)

chalk 210 231

WELL COMPLETION DATA:

streaked 231 294

(1) diameter (inches) 4"

chalk 294 399

(2) total depth (feet) 525'

(3) static water level (feet) 140' below top of ground.

streaked 399 525

(4) casing steel, 420' (material) (depth)

(size) If telescope see back.

(5) screen Open ended (length) (depth to top)

CODED

(size) (material)

(6) pump 70 (HP) (yield gpm)

AC (type power)

(7) electric log (yes or no)

DEPT. OF NATURAL RESOURCES
BUREAU OF LAND & WATER RESOURCES

(organization running log)

(8) how well bottom plugged ~~being~~ open ended


MAR 3 1982

RECEIVED

DRILLERS REMARKS:

If well telescopes please sketch and show depths.

GROUND LEVEL

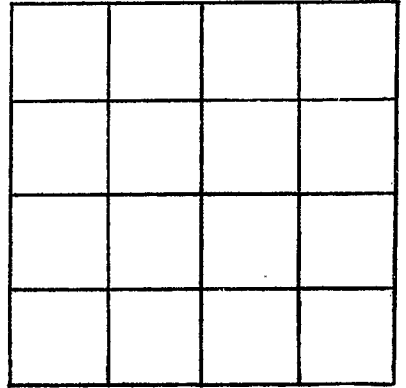

SECTION _____

Please indicate well location X.

ADDITIONAL INFORMATION

If more than one screen,
show locations of each on sketch.