

MISSISSIPPI DEPARTMENT OF NATURAL RESOURCES

Bureau of Land and Water Resources

Southport Mall

P.O. Box 10631

Jackson, Mississippi 39209

CODED

WATER WELL DRILLERS LOG

WAYNE
D 32
4/2/83

4-2-83 Griner Drilling Service, INC.

Wayne

date well completed

firm name

county well located

LANDOWNER:
JHJ Drilling, Inc.
Route 4, Box 6188
Ellisville, Ms. 39437
(mailing address)

description of formations encountered	from	to
clay, rock, shell	0	273
5' of sand - little shell	273	315

WELL LOCATION: 6515416431E
sec 19 T 10N R 6 E NW/4
No. 1 James Chaparral Field
E. 0.000 miles (direction) (nearest town)

clay	315	413
------	-----	-----

WELL PURPOSE: oil field supply
(home, irrigation, municipal, industrial)

CODED

WELL COMPLETION DATA:

(1) diameter (inches) 3"

(2) total depth (feet) 441'

(3) static water level (feet) 100' below top of ground.

(4) casing steel 315' (material) (depth)
3" (size) If telescope see back.

(5) screen 42' 273' (length) (depth to top)
3" perforated (size) (material)

(6) pump — 40-45 (HP) (yield gpm)
AC (type power)

(7) electric log — (yes or no)
(organization running log)

(8) how well bottom plugged orange
peel

Drilled 2-3" water wells on location - information logs, etc. the same

DEPT. OF NATURAL RESOURCES
BUREAU OF LAND & WATER RESOURCES


MAY 16 1983

RECEIVED

DRILLERS REMARKS:

If well telescopes please sketch and show depths.

GROUND LEVEL

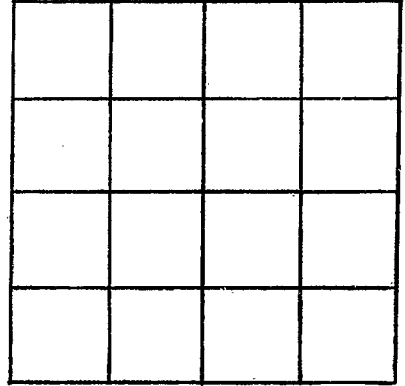

SECTION _____

Please indicate well location X.

ADDITIONAL INFORMATION

If more than one screen,
show locations of each on sketch.