

MISSISSIPPI DEPARTMENT OF NATURAL RESOURCES

Bureau of Land and Water Resources

Southport Mall

P.O. Box 10631

Jackson, Mississippi 39201

WATER WELL DRILLERS LOG

D33
Wayne
9-1-85

CODED under ?

9-13-85
date well completed

McDonald & Hill
firm name

Wayne
county well located

LANDOWNER: St. Luke United
Meth Church, Waynesboro
Rt # 2 Box 252
(mailing address)

description of formations encountered	from	to
CLAY + SAND	0	12
Blue clay	12	90
Rock st shells	90	140
Fine sand shale	140	170
Brown shale	170	230
Rock st shells	230	255
Course sand & shells	255	260
Sandy	260	280

WELL LOCATION:
sec 12 T 10 N R 17 E 6W
2 miles SE of Mathersville
(distance) (direction) (nearest town)

WELL PURPOSE: Church
(home, irrigation, municipal, industrial)

- WELL COMPLETION DATA:
- (1) diameter (inches) 4
 - (2) total depth (feet) 280
 - (3) static water level (feet) 38 below top of ground
 - (4) casing PVC 180 (material), (depth)
4 (size) if telescope see back.
 - (5) screen none (length), (depth to top)
 - (6) pump 1 (HP) 5 GPM (material), (yield gpm)
(type power)
 - (7) electric log (yes or no)
(organization running log)
 - (8) how well bottom plugged


RECEIVED

SEP 23 1985

DRILLERS REMARKS:

If well telescopes please sketch and show depths.

GROUND LEVEL

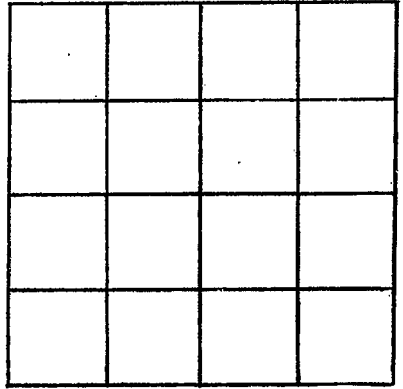

SECTION _____

Please indicate well location X.

ADDITIONAL INFORMATION

If more than one screen,
show locations of each on sketch.