

MISSISSIPPI DEPARTMENT OF NATURAL RESOURCES

Bureau of Land and Water Resources

COUNTY WELL LOCATED
Wayne

WELL NUMBER CODED
No. 1 D 34

No. 1 Gray

DATE WELL COMPLETED
11-16-88

275D

PERMIT NUMBER

NAME OF DRILLING FIRM
Griner Drilling Service, Inc.

CODED

P.O. Box 10631
Jackson, Mississippi 39209
WATER WELL DRILLERS LOG

NAME & MAILING ADDRESS OF LANDOWNER
Weeks Exploration
1100 Milam
Houston, Texas 77002

WELL LOCATION: SEC TOWNSHIP RANGE
27 10^N 6^W

DISTANCE DIRECTION NEAREST TOWN
North Cypress Ck. Field

OTHER MARKS
600' S + 600' E OF NW COR.

WELL PURPOSE: Home, Irrigation, Municipal, Industrial, Fish Pond, etc.
Oilfield Rig Supply

PUMP DATA

PUMP TYPE (Circle One):
Submersible, Turbine, Jet, Flowing Well, Other (Describe) **1 1/2 ft lift**

POWER TYPE (Circle One):
Electric, Motor, Diesel, Gasoline, Butane, Other (Describe) **Water pump**

Pump Capacity (GPM) No. of Stages Setting Depth
No pump FT.

PUMP TEST
No pump

Well yielded **80** GPM with a drawdown of **N/A** ft. after **3** **blowing** hours of pumping

WELL DATA

Well Depth 520'	Casing Diameter (In.) 4"	Casing Length (Ft) 360'
Type of Casing PVC	Hole Depth 520'	Depth to Static Water Level 50'

TYPE OF COMPLETION: (Circle One or More):
 Gravel Packed, Underreamed, Telescoped, Natural Development, Open Hole, Other (Describe)

Top of Lap Pipe or Reduction in Casing
FEET IF TELESCOPED OR MORE THAN ONE SCREEN: USE BACK PAGE

LOG DATA

TYPE OF LOG RUN (Circle One):
No Log Run, Electric, Gamma Ray, Density, Sonic, Neutron, Other (Describe)

Name of Organization Running Log

SCREEN DATA

Diameter - Inches 4" Casing	Length - Feet	Slot Size - Inches
Screen Type Open ended well	Depth - Feet	

GEOLOGIC DATA (Office Use Only)


Surface Elev.	Geologic Unit	Unit Thickness	Depth to Top
Subs. SWL	Date	Analysis	Aquifer Test

DESCRIPTION OF FORMATIONS ENCOUNTERED	FROM	TO	FORMATIONS (Continued)	FROM	TO
clay, rock, shale		320	RECEIVED JAN 27 1989 Department of Natural Resources Bureau of Land & Water Resources		
lime rock	320	360			
clay, sand, rock	360	520			

IF MORE SPACE IS NEEDED, USE BACK

If well telescopes please
sketch and show depths.

GROUND LEVEL

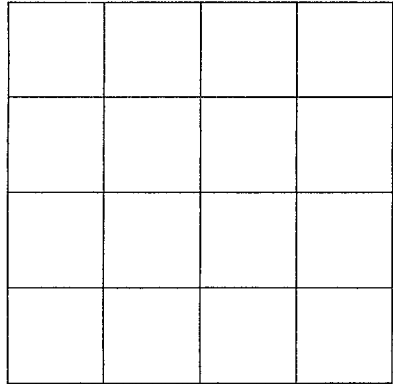

SECTION _____

Please indicate well location X.

ADDITIONAL INFORMATION

If more than one screen,
show location of each on sketch.