

**WAYNE**  
D35

MISSISSIPPI DEPARTMENT OF NATURAL RESOURCES

Bureau of Land and Water Resources

Southport Mall

P.O. Box 10631

Jackson, Mississippi 39209

WATER WELL DRILLERS LOG

Griner Drilling Service, Inc.

Wayne

7-12-90 date well completed

Griner Drilling Service, Inc. firm name

Wayne county well located

2750

LANDOWNER:  
ParCo Drilling Co.  
P.O. Box 873  
Natchez, Ms. 39120  
(mailing address)

description of formations encountered	from	to
clay	0	168
sand, shale	168	252
clay	252	315
lime rock	315	378

WELL LOCATION: 330<sup>9</sup> + 1650<sup>10</sup> W of  
sec. 26 T 10<sup>N</sup> R 6 E S 1<sup>W</sup> Sulco  
moon Hill 1.5 miles W of Waynesboro  
(distance) (direction) (nearest town)

WELL PURPOSE: oil field rig supply  
(home, irrigation, municipal, industrial)

- WELL COMPLETION DATA:
- (1) diameter (inches) 3"
  - (2) total depth (feet) 378'
  - (3) static water level (feet) 30' below top of ground.
  - (4) casing PVC 180' (material) (depth)  
3" (size) if telescope see back.
  - (5) screen No Screen (length) (depth to top)  
open ended well (size) (material)
  - (6) pump 60 (HP) (yield gpm)  
Air Compressor (type power)
  - (7) electric log (yes or no)
  - (organization running log)
  - (8) how well bottom plugged open ended well


RECEIVED  
OCT 31 1990

Department of Natural Resources  
Bureau of Land & Water Resources

DRILLERS REMARKS:

If well telescopes please sketch and show depths.

GROUND LEVEL

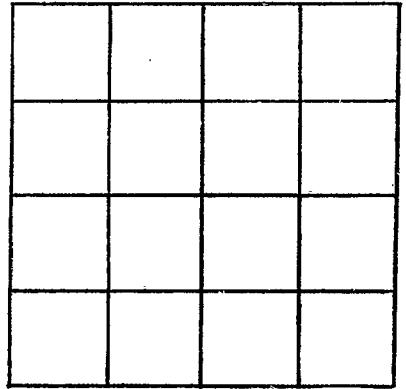

SECTION \_\_\_\_\_

Please indicate well location X.

ADDITIONAL INFORMATION

If more than one screen,  
show locations of each on sketch.