

WAYNE
D 2002
12-8-80

MISSISSIPPI
 BOARD OF WATER COMMISSIONERS
 416 North State Street
 Jackson, Mississippi 39201

WATER WELL DRILLERS LOG

12-8-80 19 McDonald & Hill Wayne
 date well completed firm name county well located

LANDOWNER: MATHERS
Dr. Alex. Mathews
Mathersville
 (mailing address)

WELL LOCATION:
 sec. 3 T 12 N R 6 E
S W
Mathersville
 (distance) miles (direction) of (nearest town)

WELL PURPOSE: home
 (home, irrigation, municipal, industrial)

- WELL COMPLETION DATA:
- (1) diameter (inches) 4"
 - (2) total depth (feet) 1040
 - (3) static water level (feet) 87 below above top of ground.
 - (4) casing PVC, 385,
 (material) (depth)
4" if telescope see back.
 (size)
 - (5) screen _____
 (length) (depth to top)
 (size) (material)
 - (6) pump 1 1/2 Jacm
 (HP) (yield/gpm)
E
 (type power)
 - (7) electric log _____
 (yes or no)
 (organization running log)
 - (8) how well bottom plugged open

description of formations encountered	from	to
clay & sand	0	22
sandy shale & rock	22	60
blue shale	60	100
sandy shale & rock	100	110
shale	110	130
sand & shale & shell	130	205
shale	205	210
sandy shale & rock	210	320
shale	320	335
blue sand & shale	335	355
shale w/ coarse sand	355	380
shale	380	400
st. sand shale & gravel	400	460
shale	460	496
sandy shale & rock	496	510
st. c. rock	510	535
green sand	535	680
shale & rock	680	760
shale & sand	760	825
shale	825	835
fine sand & shell	835	880
shale & sand	880	1040
shale & lignite	1040	


DEPT. OF NATURAL RESOURCES
 BUREAU OF LAND & WATER RESOURCES

DEC 15 1980
 RECEIVED

DRILLERS REMARKS:

If well telescopes please sketch and show depths.

GROUND LEVEL

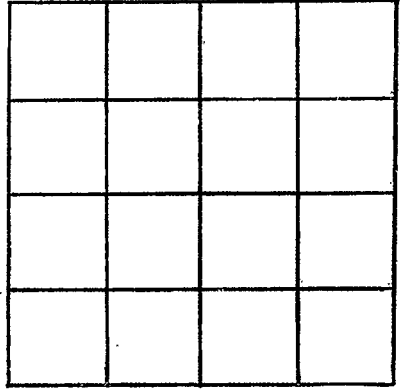

SECTION _____

Please indicate well location X.

ADDITIONAL INFORMATION

If more than one screen, show locations of each on sketch.