

MISSISSIPPI DEPARTMENT OF NATURAL RESOURCES

Bureau of Land and Water Resources

Southport Mall

P.O. Box 10631

Jackson, Mississippi 39209


WATER WELL DRILLERS LOG

Wayne
D 2008

11-15-83 date well completed McDonald well firm name Wayne county well located


LANDOWNER:	description of formations encountered	from	to
Wilson Waller	Clay	0	20
Rt # 6 Box 925 Wayne MS (mailing address)	shale	20	165
WELL LOCATION: sec. 19 T 10 N R 6 E 6 miles SE of Shubuta (distance) (direction) (nearest town)	sandy shale + rock	165	210
	shale	210	265
WELL PURPOSE: none (home, irrigation, municipal, industrial)	sandy shale + shell fine sand	265	280
WELL COMPLETION DATA:	Brown shale + sand	280	325
(1) diameter (inches) 4"	Meal to coarse sand	325	340
(2) total depth (feet) 340'			
(3) static water level (feet) 125' below top of ground.			
(4) casing PVC 960' (material) (depth) 4" 80' 2" PVC (size) If telescope see back.			
(5) screen 10 330 to 340 (length) (depth to top) 2" PVC 2000 (size) (material)			
(6) pump 1 80 gpm (HP) (yield gpm)			
(7) electric log (yes or no)			
(organization running log)			
(8) how well bottom plugged Valve			

DRILLERS REMARKS: 1- shale trap
1- Rubber seal set at 250'

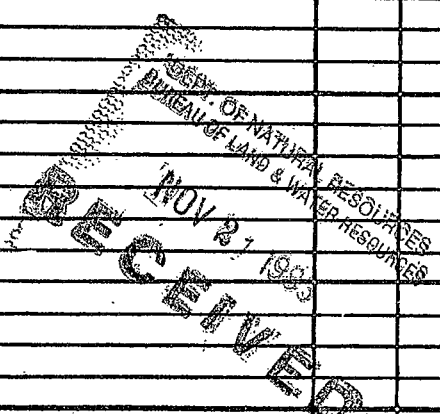

If well telescopes please sketch and show depths.

GROUND LEVEL

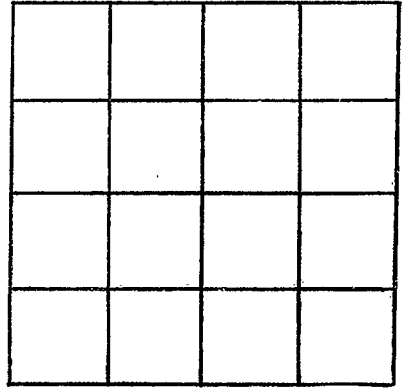

SECTION _____

Please indicate well location X.

ADDITIONAL INFORMATION

If more than one screen,
show locations of each on sketch.