

WAYNE
D 2005

MISSISSIPPI
BOARD OF WATER COMMISSIONERS
416 North State Street
Jackson, Mississippi 39201

WATER WELL DRILLERS LOG

6-18 1984 Roy G. West Dalg WAYNE
date well completed firm name county well located

LANDOWNER:	description of formations encountered	from	to
Robert Jones Shubutta MS (mailing address)		Red clay SANDY CLAY SAND CLAY SAND	0 2 32 34 291
WELL LOCATION: sec. 18 T. 10 N. R. 6 E S 48 miles SE of Shubutta (distance) (direction) (nearest town)			
WELL PURPOSE: (home, irrigation, municipal, industrial)			
WELL COMPLETION DATA:			
(1) diameter (inches) 4"			
(2) total depth (feet) 316'			
(3) static water level (feet) 93' below top of ground.			
(4) casing PVC, 306' (material) (depth)			
(size) If telescope see back.			
(5) screen 10', 306' (length) (depth to top)			
4" PVC (size) (material)			
(6) pump 1 1/2 HP, 9 (HP) (yield gpm)			
REA (type power)			
(7) electric log no (yes or no)			
(organization running log)			
(8) how well bottom plugged WAS VALVE			

DEPT. OF NATURAL RESOURCES
BUREAU OF LAND & WATER RESOURCES


JUL 5 1984

DRILLERS REMARKS:

RECEIVED

If well telescopes please sketch and show depths.

GROUND LEVEL

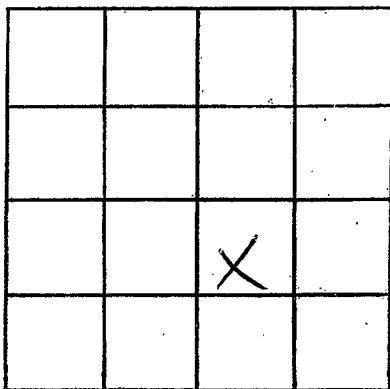

SECTION

18

Please indicate well location X:

ADDITIONAL INFORMATION

If more than one screen, show locations of each on sketch.