

MISSISSIPPI DEPARTMENT OF NATURAL RESOURCES

Bureau of Land and Water Resources

Southport Mall

P.O. Box 10631

Jackson, Mississippi 39209

WATER WELL DRILLERS LOG

WAYNE
D. JONES

4.22.86
date well completed

McDONALD + HILL
firm name

WAYNE
county well located

LANDOWNER:	description of formations encountered	from	to
LAWRENCE + BARBARA STAR RD Box 28 SHUBUTA (mailing address)	JONES MS		
WELL LOCATION: sec. 19 T. 10 N. R. 17 E. 5 miles S.E. of MATHEWSVILLE (distance) (direction) (nearest town)	CLAY SAND + PLAY BLUE SHALE SHALE ST SHELLS SAND ST SHELLS FINE SAND ST SAND SAND ST SHALE SHALE SAND ST SHELLS ROCK ST SHELLS ST SAND + SHELLS	0 10 25 100 120 160 180 184 250 270 310	10 25 100 120 160 180 194 250 310 340
WELL PURPOSE: HOME (home, irrigation, municipal, industrial)			
WELL COMPLETION DATA:			
(1) diameter (inches) 4"			
(2) total depth (feet) 340'			
(3) static water level (feet) 75' below top of ground.			
(4) casing PVC, 210' (material), (depth), 4" (size) if telescope see back.			
(5) screen (length), (depth to top), (size), (material)			
(6) pump (HP), (yield gpm), (type power)			
(7) electric log (yes or no), (organization running log)			
(8) how well bottom plugged OPEN			


RECEIVED
MAY 5 1986

Department of Natural Resources
Bureau of Land and Water Resources

DRILLERS REMARKS:

If well telescopes please sketch and show depths.

GROUND LEVEL

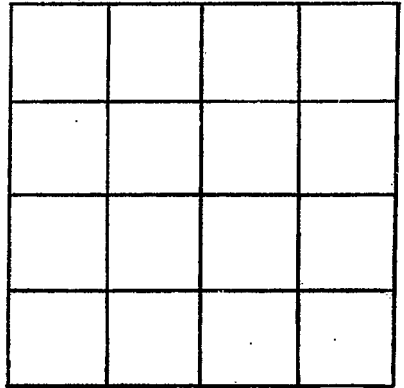

SECTION _____

Please indicate well location X.

ADDITIONAL INFORMATION

If more than one screen, show locations of each on sketch.