

MISSISSIPPI DEPARTMENT OF NATURAL RESOURCES

Bureau of Land and Water Resources

P.O. Box 10631

Jackson, Mississippi 39209

WATER WELL DRILLERS LOG

COUNTY WELL LOCATED WAYNE	
WELL NUMBER D 2008	CODED
DATE WELL COMPLETED 9/15/88	

PERMIT NUMBER 205
NAME OF DRILLING FIRM CARR'S WELL SER
BUCKATUNNA, MR.

NAME & MAILING ADDRESS OF LANDOWNER ALLEN DOUGH (MRS)		
RT. 6		
WAYNESBORO MS. 39367		
WELL LOCATION: SEC	TOWNSHIP	RANGE
2	10	N 6
DISTANCE	DIRECTION	NEAREST TOWN
6 Miles	N	of WAYNESBORO
OTHER LANDMARK		
WELL PURPOSE: <input checked="" type="checkbox"/> Home Irrigation, <input type="checkbox"/> Municipal, <input type="checkbox"/> Industrial, <input type="checkbox"/> Fish Pond, etc.		

PUMP DATA		
PUMP TYPE (Circle One): Submersible, Turbine, <input checked="" type="radio"/> Jet, Flowing Well, Other (Describe) _____		
POWER TYPE (Circle One): <input checked="" type="radio"/> Electric, Tractor, Diesel, Gasoline, Butane, Other (Describe) _____ H/P LHA		
Pump Capacity (GPM)	No. of Stages	Setting Depth
8	2	21 FT.
PUMP TEST		
Well yielded 8 GPM with a drawdown of 4 ft. after 1 hours of pumping		

WELL DATA		
Well Depth 28	Casing Diameter (In.) 2"	Casing Length (Ft.) 22
Type of Casing PVC	Hole Depth 2"	Depth to Static Water Level 15
TYPE OF COMPLETION: (Circle One or More): <input checked="" type="checkbox"/> Gravel Packed, <input type="checkbox"/> Underreamed, <input type="checkbox"/> Telescoped, <input checked="" type="checkbox"/> Natural Development, <input type="checkbox"/> Open Hole, <input type="checkbox"/> Other		
Top of Lap Pipe or Reduction in Casing		
FEET <input type="checkbox"/> IF TELESCOPED OR MORE THAN ONE SCREEN: USE BACK PAGE		

LOG DATA	
TYPE OF LOG RUN (Circle One): No Log Run, Electric, Gamma Ray, Density, Sonic, Neutron, Other (Describe) _____	
Name of Organization Running Log	

SCREEN DATA		
Diameter - Inches 2"	Length - Feet 5'	Slot Size - Inches 6
Screen Type PVC	Depth to Bottom - Feet 27	


GEOLOGIC DATA (Office Use Only)			
Surface Elev.	Geologic Unit	Unit Thickness	Depth to Top
Subs. SWL	Date	Analysis	Aquifer Test
Driller's Remarks			

DESCRIPTION OF FORMATIONS ENCOUNTERED	FROM	TO
Top 50:1 CHALK	0	1
ME. SP	1	14
	14	27

FORMATIONS (Continued)	FROM	TO
DEC 13 1988		
Department of Natural Resources Bureau of Land & Water Resources		
IF MORE SPACE IS NEEDED, USE BACK		

If well telescopes please
sketch and show depths.

GROUND LEVEL

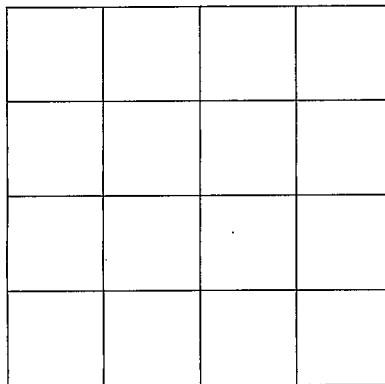

SECTION _____

Please indicate well location X.

ADDITIONAL INFORMATION

If more than one screen,
show location of each on sketch.