

WAYNE

MISSISSIPPI BOARD OF WATER COMMISSIONERS

E 5

7-16-65

WATER WELL DRILLERS LOG

Date: July 16, 1965, Driller: Portland Drilling & Supply Co., Wayne County, Wayne


(1) Owner of Land: Walter Belden
 (Name)
At 2 Waynesboro
 (Address)
 (2) Location: NW 1/4, SE 1/4, Sec. 34 T10R5
13 miles NE, of Waynesboro
 (distance) (direction) (Nearest Town)
 (3) Topography: flat
 (Hilly) (Flat) (Level)
 (4) Purpose of Well: domestic
 (Domestic Irrigation, Municipal, Industrial, Other)

Description & Color of Materials Sand, Clay, Red Clay, Shell, etc.	Thick- ness Feet	Depth Feet
sandy dirt	6	6
sand	10	16
blue chalk	37	53
thin rock		53
hard chalk & soft		
lime rock	4	57
red dirt like 58'		
lime rock	2	59
light shell & brown		
chalk	9	68
brown chalk	16	84
fine brown sand		
& shell	32	116
red coarse brown		
sand & shell	13	129
strip on chalk		

Information upon completion of well:

(1) Diameter 2" inches.
 (2) Total Depth 129' feet.
 (3) Water Level 8' feet below top of ground.
 (4) Cased to 118', Size 2"
 (5) Screen: Size 1 1/4", Length 12'
60 ga
 (6) Were any formations sealed against pollution?
 _____ yes, X no.

If YES depth of formation _____
 Why _____
 Drillers Remarks: _____

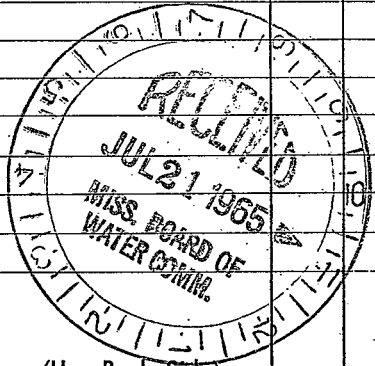

(Use Back Side)

Well No.

