

Wayne
E 6
11-5-68

MISSISSIPPI
BOARD OF WATER COMMISSIONERS
416 North State Street
Jackson, Mississippi 39201

CODED

WATER WELL DRILLERS LOG

NOV. 5 1968 - McDonald + Hill Inc Wayne
date well completed firm name county well located

LANDOWNER: Cecil Brown

description of formations encountered

from to

Rt 2

Clay

0 20

Shell

20 90

Waynesboro, Miss
(mailing address)

Sandy

90 100

Shell

100 130

WELL LOCATION:

STREAKS sand

130 155

sec. 6 T 10 N R 5 E
S W
2 miles east of Matherville
(distance) (direction) (nearest town)

Sandy

155 175

STREAKS sand

175 185

shell

185 200

lime shell + rock

200 280

Sandy

280 300

WELL PURPOSE: home
(home, irrigation, municipal, industrial)

WELL COMPLETION DATA:

(1) diameter (inches) 4"

(2) total depth (feet) 300

(3) static water level (feet) 95 below top of ground.

(4) casing 4" 105'
(material) (depth)

(size) if telescope see back.

(5) screen (length) (depth to top)

(size) (material)

(6) pump (HP) (yield gpm)

(type power)

(7) electric log (yes or no)

(organization running log)

(8) how well bottom plugged

CODED


NOV 7 1968

MISS. Bd OF WATER COMMISSIONERS

DRILLERS REMARKS:

If well telescopes please sketch and show depths.

GROUND LEVEL

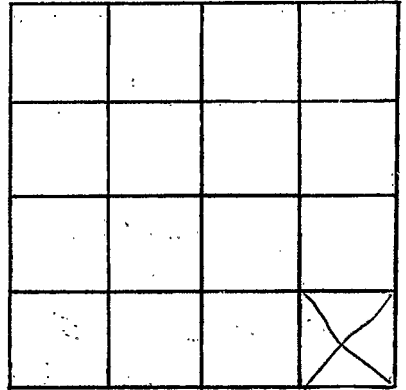

SECTION 6

Please indicate well location X.

ADDITIONAL INFORMATION

If more than one screen,
show locations of each on sketch.