

MISSISSIPPI
BOARD OF WATER COMMISSIONERS
416 North State Street
Jackson, Mississippi 39201

CODED

WATER WELL DRILLERS LOG

WAYNE
E7
9-4-70

9/4 1970 date well completed Region Well Service firm name Wayne county well located

LANDOWNER: Dr. Cole

description of formations encountered	from	to
	SAND	0
GRAVEL	60	90

WAYNESBORO, MISS (mailing address)

WELL LOCATION:
sec. 8 T 10 N R 18 E
S W
5 miles SE of MATHERSVILLE
(distance) (direction) (nearest town)

WELL PURPOSE: CAMP
(home, irrigation, municipal, industrial)

- WELL COMPLETION DATA:
- (1) diameter (inches) 2/90
 - (2) total depth (feet) 90
 - (3) static water level (feet) 1 below/above top of ground
 - (4) casing Galv. 18
(material) (depth)

CODED

- (5) screen Open End
(length) (depth to top)
(size) (material)
- (6) pump 1/3 6
(HP) (yield gpm)

Elec
(type power)

(7) electric log No
(yes or no)

(organization running log)

(8) how well bottom plugged B.W.V


OCT 21 1970

DRILLERS REMARKS:

MISS. BD. OF
WATER COMM.

If well telescopes please sketch and show depths.

GROUND LEVEL

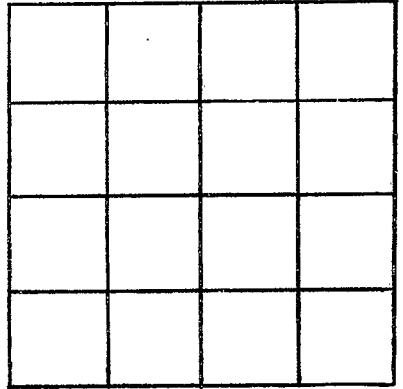

SECTION _____

Please indicate well location X.

ADDITIONAL INFORMATION

If more than one screen, show locations of each on sketch.