

WAYNE
E 11
2-4-74

MISSISSIPPI
 BOARD OF WATER COMMISSIONERS
 416 North State Street
 Jackson, Mississippi 39201

CODED

WATER WELL DRILLERS LOG

McILWAIN WATER WELL SERVICE *Wayne*

Feb 4, 1974
 date well completed

RT. 2, Box 37

county well located

WAYNESBORO, MISS. 39367

LANDOWNER:	description of formations encountered	from	to
<i>ALBERT Mc Kay</i>			
<i>Rt 2 Waynesboro, Miss</i> (mailing address)	<i>Clay</i>	<i>3</i>	<i>10</i>
WELL LOCATION:	<i>SAND</i>	<i>10</i>	<i>12</i>
sec. <i>32</i> <i>10</i> N R. <i>5</i> W	<i>BLUE CLAY</i>	<i>12</i>	<i>20</i>
<i>14</i> miles <i>NE</i> of <i>W'BORO</i> (distance) (direction) (nearest town)	<i>LIMY ROCKS AND LAYERS OF CLAY</i>	<i>20</i>	<i>37</i>
WELL PURPOSE: <i>HOME</i> (home, irrigation, municipal, industrial)	<i>HARD ROCK</i>	<i>37</i>	<i>39</i>
WELL COMPLETION DATA:	<i>MED. SAND</i>	<i>39</i>	<i>50</i>
(1) diameter (inches) <i>2"</i>			
(2) total depth (feet) <i>50'</i>			
(3) static water level (feet) <i>13'</i> below top of ground.			
(4) casing <i>PVC</i> , <i>40'</i> (material) (depth)			
<i>2"</i> (size) If telescope see back.			
(5) screen <i>10'</i> , <i>40'</i> (length) (depth to top)			
<i>2"</i> , <i>PVC .008</i> (size) (material)			
(6) pump <i>1</i> , <i>13</i> (HP) (yield gpm)			
<i>220 AC</i> (type power)			
(7) electric log <i>700</i> (yes or no)			
(organization running log)			
(8) how well bottom plugged			


CODED

FEB 19 1974
 MISSISSIPPI BOARD OF WATER COMMISSIONERS

DRILLERS REMARKS:

If well telescopes please sketch and show depths.

GROUND LEVEL

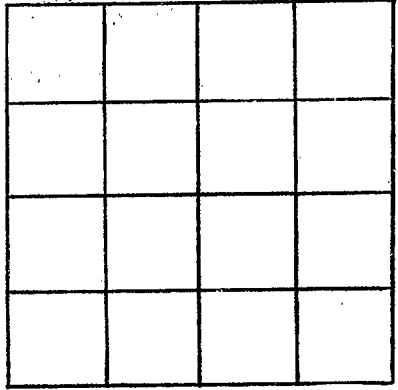

SECTION _____

Please indicate well location X.

ADDITIONAL INFORMATION

Lined area for additional information, consisting of approximately 20 horizontal lines.

If more than one screen, show locations of each on sketch.