

WAYNE
E 13
8-6-74

MISSISSIPPI
BOARD OF WATER COMMISSIONERS
416 North State Street
Jackson, Mississippi 39201

TECP
CODED

WATER WELL DRILLERS LOG

AUG 6, 1974 19 McILWAIN WATER WELL SERVICE WAYNE
date well completed RT. 2 BOX 37 county well located
WAYNESBORO, MISS. 39367

LANDOWNER:
HUGH SANDERSON
RT 2 WAYNESBORO, MISS.
(mailing address)

WELL LOCATION:
sec 27 T 10 N R 5 E
15 miles NE of W'BORO
(distance) (direction) (nearest town)

WELL PURPOSE: HOME
(home, irrigation, municipal, industrial)

- WELL COMPLETION DATA:
- (1) diameter (inches) 2"
 - (2) total depth (feet) 142'
 - (3) static water level (feet) 6' below
top of ground
 - (4) casing PVC 132'
(material) (depth)
2" If telescope see back.
(size)
 - (5) screen 10' 132'
(length) (depth to top)
2" PVC .008
(size) (material)
 - (6) pump 1/2 10
(HP) (yield gpm)
110 AC
(type power)
 - (7) electric log no.
(yes or no)

(organization running log)


(8) how well bottom plugged

DRILLERS REMARKS:

description of formations encountered	from	to
Clay	0	8
Sand	8	12
Blue Clay	12	60
Sand, clay, rock	60	68
Rock	68	72
Clay, sand, shells & rock	72	76
Brown Shale	76	95
Clay, sand Sea Shells	95	125
Sand	125	142
CODED		
DEC 18 1974		
MISS. Bd. OF WATER COMMISSIONERS		

If well telescopes please sketch and show depths.

GROUND LEVEL

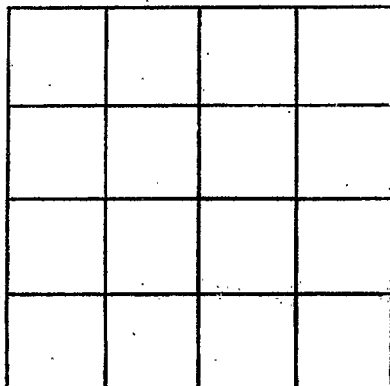

SECTION _____

Please indicate well location X.

ADDITIONAL INFORMATION

If more than one screen, show locations of each on sketch.