

WAYNE
E 15
11/19/74

MISSISSIPPI
BOARD OF WATER COMMISSIONERS
416 North State Street
Jackson, Mississippi 39201

CODED

WATER WELL DRILLERS LOG

11-19-74 date well completed
McDONALD + HILL firm name
WAYNE county well located

LANDOWNER:

JOHN E STAGG
P.O. 29 WAYNESBORO
(mailing address)

description of formations encountered

from to

CLAY ST SAND	0	20
SHALE	20	32
SANDY ST SHELLS	32	50
BLUE CLAY	50	125
BROWN SHALE	125	147
BROWN SAND ST SHALE	147	165
SAND ST SHALE	165	180

WELL LOCATION:

sec. 6 T. 10 N. R. 6 E.
2 miles EAST of MADISONVILLE
(distance) (direction) (nearest town)

WELL PURPOSE: HOME
(home, irrigation, municipal, industrial)

WELL COMPLETION DATA:

- (1) diameter (inches) 4"
- (2) total depth (feet) 180'
- (3) static water level (feet) 70' below top of ground.
- (4) casing PVC 144' (material) (depth)
4" (size) if telescope see back.
- (5) screen 10' 170' (length) (depth to top)
2" PVC (size) (material)
- (6) pump 1 hp 10 (HP) (yield gpm)
ELECTRIC (type power)
- (7) electric log (yes or no)
- (8) how well bottom plugged VALVE

CODED

RECEIVED
NOV 29 1974


DRILLERS REMARKS:

32'-2" PVC
1-4 X 2 SEAL

MISS. RD. OF WATER COMMISSIONERS

If well telescopes please
sketch and show depths.

GROUND LEVEL

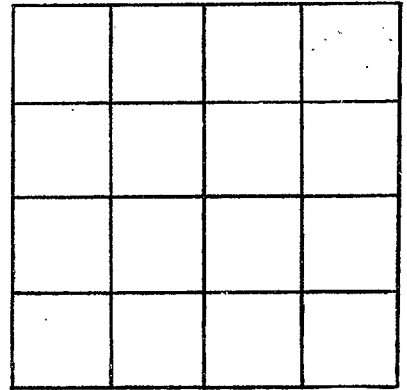

SECTION _____

Please indicate well location X.

ADDITIONAL INFORMATION

If more than one screen,
show locations of each on sketch.