

Wayne
E 2000
12/3/75

MISSISSIPPI
BOARD OF WATER COMMISSIONERS
416 North State Street
Jackson, Mississippi 39201
WATER WELL DRILLERS LOG

DEC 3, 1975 19 McILWAIN WATER WELL SERVICE WAYNE
date well completed RT. 2, BOX 37 county well located
WAYNESBORO, MISS. 39367

LANDOWNER:	description of formations encountered	from	to
MRS G. M. MOODY	Clay	0	15
RT 2 WAYNESBORO, MISS. (mailing address)	Sand	15	29
WELL LOCATION:	Clay	29	53
sec. 31 T-10 N R-5 E 10 miles NE of W ^B BORO (distance) (direction) (nearest town)	Rock & Clay	53	60
WELL PURPOSE: HOME (home, irrigation, municipal, industrial)	Rock & Sand layers	60	79
WELL COMPLETION DATA:			
(1) diameter (inches) 2"			
(2) total depth (feet) 79			
(3) static water level (feet) 31' below top of ground.			
(4) casing PVC 69' (material) (depth) 2" If telescope see back. (size)			
(5) screen 10' 69' (length) (depth to top) 2" PVC.008 (size) (material)			
(6) pump 3/4 10 (HP) (yield gpm) 110AC (type power)			
(7) electric log NO (yes or no)			
(organization running log)			
(8) how well bottom plugged			
DRILLERS REMARKS:			


DRILLER'S SIGNATURE

JAN 23 1976

WATER COMMISSION

If well telescopes please sketch and show depths.

GROUND LEVEL

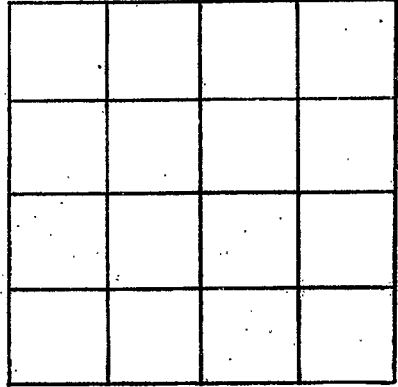

SECTION _____

Please indicate well location X.

ADDITIONAL INFORMATION

If more than one screen, show locations of each on sketch.