

Wayne  
E 2001  
8/11/76

MISSISSIPPI  
BOARD OF WATER COMMISSIONERS  
416 North State Street  
Jackson, Mississippi 39201

WATER WELL DRILLERS LOG

McILWAIN WATER WELL SERVICE

Aug 11, 1976  
date well completed

RT # 2 BOX 37  
WAYNESBORO, MISS. 39367

WAYNE  
county well located

LANDOWNER:	description of formations encountered	from	to
CECIL MOODY	Red Clay	0	5
Rt 2 Waynesboro, Miss. (mailing address)	yellow clay	5	9
WELL LOCATION:	limy rock + clay	9	12
sec. 29 T. 10 N R. 5 E S W	Sand	12	25
15 miles NE of W'BORO (distance) (direction) (nearest town)	Clay + shale	25	35
WELL PURPOSE: Home (home, irrigation, municipal, industrial)	Blue clay some shells	35	114
WELL COMPLETION DATA:	limy rock, clay shells	114	125
(1) diameter (inches) 2"	Brown clay	125	135
(2) total depth (feet) 186'	sandy marl	135	170
(3) static water level (feet) 33' below top of ground.	Sand	170	186
(4) casing PVC 178' (material) (depth) 2" If telescope see back. (size)			
(5) screen 8' 178' (length) (depth to top) 2" PVC (size) (material)			
(6) pump 1 8 (HP) (yield gpm) 220 AC (type power)			
(7) electric log no (yes or no) (organization running log)			
(8) how well bottom plugged			
DRILLERS REMARKS:			


RECEIVED

AUG 18 1976

MISS. Bd. OF WATER COMM.

If well telescopes please sketch and show depths.

GROUND LEVEL

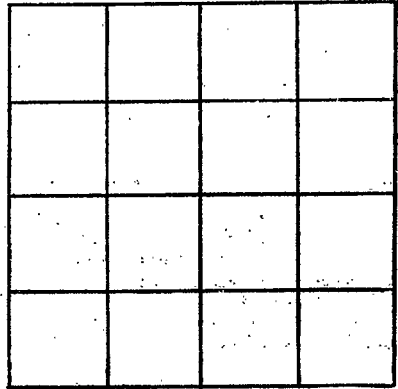

SECTION \_\_\_\_\_

Please indicate well location X.

ADDITIONAL INFORMATION

If more than one screen, show locations of each on sketch.