

Wayne  
E 2000  
9/6/76

MISSISSIPPI  
BOARD OF WATER COMMISSIONERS  
416 North State Street  
Jackson, Mississippi 39201

WATER WELL DRILLERS LOG

Sept 9 1976 date well completed 76 Porter Drilling & Exp. firm name 21 Wayne county well located


LANDOWNER: Frank Davis	description of formations encountered	from	to
Pt 2 Waynesboro Miss (mailing address)	clay	0	14
	sand	14	21
	clay	21	23
	clay	23	24
	clay	24	26
	clay	26	29
	clay & sand	29	80
	sand & clay	80	88
	mostly sand	88	105
	clay	105	120
WELL LOCATION:			
sec. 9 - T 10 N R 5 E S W			
1/4 miles E of Waynesboro (distance) (direction) (nearest town)			
WELL PURPOSE: home (home, irrigation, municipal, industrial)			
WELL COMPLETION DATA:			
(1) diameter (inches) 4"			
(2) total depth (feet) 120'			
(3) static water level (feet) 36' below top of ground.			
(4) casing P.V.C. 29' (material) (depth)			
4" (size) If telescope see back.			
(5) screen none used (length) (depth to top)			
(size) (material)			
(6) pump 3/4 10 (HP) (yield gpm)			
(type power)			
(7) electric log not (yes or no)			
(organization running log)			
(8) how well bottom plugged open			
DRILLERS REMARKS:			

RECEIVED  
NOV - 3 1976

MISS. BD. OF WATER COMMISSIONERS

If well telescopes please  
sketch and show depths.

GROUND LEVEL

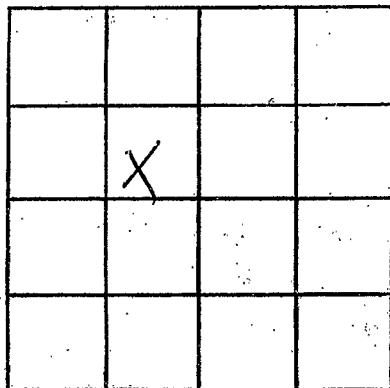

SECTION 9

Please indicate well location X.

ADDITIONAL INFORMATION

If more than one screen,  
show locations of each on sketch.