

Wayne
E 2003
9/8/76

MISSISSIPPI
BOARD OF WATER COMMISSIONERS
416 North State Street
13^P Jackson, Mississippi 39201

WATER WELL DRILLERS LOG

Sept 8 1976 Proter Drilling & Log Wayne
date well completed firm name county well located

LANDOWNER: Elton Dowe

description of formations encountered	from	to
sand & clay	0	18
blue clay	18	28
rock	28	29 1/2
blue sand	29 1/2	45
sand & clay	45	84
sand - dirty	84	90
clay sand	90	100
sand & clay	100	105

At 2 Waynesboro ms
(mailing address)

WELL LOCATION:
sec. 9 T. 10 N. R. 5 E. W
1 1/2 miles E Waynesville
(distance) (direction) (nearest town)

WELL PURPOSE: Home
(home, irrigation, municipal, industrial)

WELL COMPLETION DATA:

(1) diameter (inches) 4"

(2) total depth (feet) 100

(3) static water level (feet) 32 (below/above top of ground)

(4) casing PVC 90'
(material) (depth)
4" (size) If telescope see back.

(5) screen 10' 90'
(length) (depth to top)
2 1/2" cast S.S.
(size) (material)

(6) pump 1 12
(HP) (yield gpm)
elec
(type power)

(7) electric log no
(yes or no)

(organization running log)

shell trap on top of screen
1 1/2" back wash valve on
end of screen screen
removed on end of case
60' 2" P.V.C. tubing
58' 1" P.V.C. drop pipe

(8) how well bottom plugged
1 1/2" back wash valve


DRILLERS REMARKS:

RECEIVED
NOV - 3 1976

MISS. Bd. OF WATER COMM

If well telescopes please sketch and show depths.

GROUND LEVEL

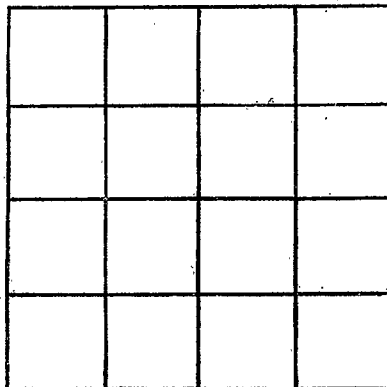

SECTION _____

Please indicate well location X.

ADDITIONAL INFORMATION

If more than one screen, show locations of each on sketch.