

WAYNE

E 2005

9-29-78

MISSISSIPPI BOARD OF WATER COMMISSIONERS
416 North State Street
Jackson, Mississippi 39201

WATER WELL DRILLERS LOG
McILWAIN WATER WELL SERVICE

Sept. 29 1978

RT. 2 BOX 37

Wayne

date well completed

WAYNESBORO, MISS. 39367

county well located


LANDOWNER:	description of formations encountered	from	to
Robert NORTON Waynesboro, MS. (mailing address)			
WELL LOCATION: sec. 20 T. 10 N R. 18 E 15 miles NE of W'boro (distance) (direction) (nearest town)	Mixed Clay	10	13
WELL PURPOSE: Home (home, irrigation, municipal, industrial)	SAND	13	28
WELL COMPLETION DATA: (1) diameter (inches) 2" (2) total depth (feet) 190' (3) static water level (feet) 23' below top of ground. (4) casing PVC, 175' (material) (depth) 2" if telescope see back. (size) (5) screen 15' 175' (length) (depth to top) 2" PVC .008 (size) (material) (6) pump 1 8 (HP) (yield gpm) 220 AC (type power) (7) electric log NO (yes or no) (organization running log)	Blue Clay & Rocks	28	80
	Blue Clay	80	115
	Hard Blue Clay		
	Rocks	115	125
	Brown Clay		
	Shells & Sand	125	170
	Brown Clay	170	175
	SAND, shells, &		
DRILLERS REMARKS:	Stone CLAY	175	190

RECEIVED
OCT 20 1978

MISS. BOARD OF WATER COMMISSIONERS

If well telescopes please sketch and show depths.

GROUND LEVEL

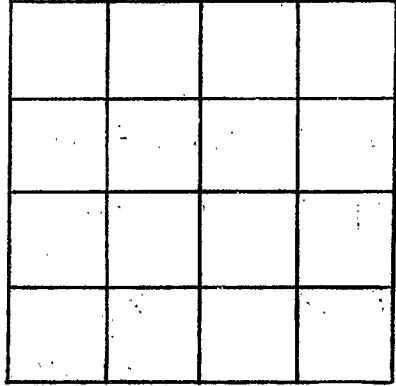

SECTION _____

Please indicate well location X.

ADDITIONAL INFORMATION

If more than one screen,
show locations of each on sketch.